

CODED

MARSHALL

R 10

4-29-69

MISSISSIPPI BOARD OF WATER COMMISSIONERS
416 North State Street
Jackson, Mississippi 39201

WATER WELL DRILLERS LOG

4-29
date well completed

1969 Atkinson & Frost
firm name

Marshall
county well located

LANDOWNER:

Annie B. Martin
Holly Springs Miss
(mailing address)

description of formations encountered

from to

Red Clay	0	15
Red sand	15	80
white sand	80	190
white Clay	190	200
white sand	200	240

WELL LOCATION:

sec. 4 T. 5 N R. 4 E
15 miles SW of Holly Springs
(distance) (direction) (nearest town)

WELL PURPOSE:

(home, irrigation, municipal, industrial)

WELL COMPLETION DATA:


- (1) diameter (inches) 4"
- (2) total depth (feet) 240
- (3) static water level (feet) 185 below top of ground.
- (4) casing PVC 230 (material) (depth)
(size) if telescope see back.
- (5) screen 10 230 (length) (depth to top)
4" P.V.C. (size) (material)
- (6) pump 3/4 10 (HP) (yield gpm)
Elex (type power)
- (7) electric log (yes or no)
(organization running log)
- (8) how well bottom plugged CAP

DRILLERS REMARKS:

SEP 5 1969
MISS. REG. OF WATER QUALITY

If well telescopes please sketch and show depths.

GROUND LEVEL

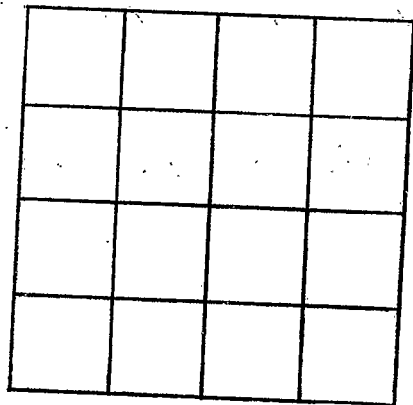

SECTION _____

Please indicate well location X.

ADDITIONAL INFORMATION

If more than one screen,
show locations of each on sketch.