

CODED

MISSISSIPPI
BOARD OF WATER COMMISSIONERS
416 North State Street
Jackson, Mississippi 39201

WATER WELL DRILLERS LOG

Marshall
R 11
10-3-69

10-3-69 date well completed 1969 Attention & Fort Marshall firm name Marshall county well located

LANDOWNER:
Mary Beckin
Scho N.M. Miss.
(mailing address)

description of formations encountered	from	to
Clay	0	10
red sand	10	80
white sand	80	205
pinkish clay	205	220
white sand	220	265

WELL LOCATION:
sec. 4 T. 5 N. R. 4 E.
6 miles SW of Galena
(distance) (direction) (nearest town)

WELL PURPOSE:
(home, irrigation, municipal, industrial)

- WELL COMPLETION DATA:
- (1) diameter (inches) 4"
 - (2) total depth (feet) 265
 - (3) static water level (feet) 160 below top of ground
 - (4) casing P.V.C. 235 (material) (depth)
(size) if telescope see back.
 - (5) screen 10 235 (length) (depth to top)
6" P.V.C. (size) (material)
 - (6) pump 3/4 10 (HP) (yield gpm)
elec. (type power)
 - (7) electric log (yes or no)
(organization running log)
 - (8) how well bottom plugged CAP.


DRILLERS REMARKS

NOV 9 1969

MISS. Bd. of WATER COM.

If well telescopes please sketch and show depths.

GROUND LEVEL

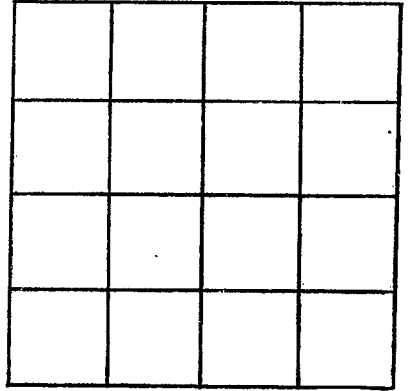

SECTION _____

Please indicate well location X.

ADDITIONAL INFORMATION

If more than one screen,
show locations of each on sketch.