

MISSISSIPPI
BOARD OF WATER COMMISSIONERS
416 North State Street
Jackson, Mississippi 39201

CODED

Marshall
R 13
2-25-70
2-25-70 19
date well completed

WATER WELL DRILLERS LOG
A. Keison & Frost firm name
Marshall county well located

LANDOWNER:
H. P. Stephenson
Nelly Springs Miss
(mailing address)

description of formations encountered	from	to
	<u>Clay</u>	<u>0</u>
<u>Red Sand</u>	<u>15</u>	<u>65</u>
<u>White Clay</u>	<u>65</u>	<u>75</u>
<u>White Sand</u>	<u>75</u>	<u>185</u>

WELL LOCATION:
sec. 4 T. 5 N. R. 4 E
2 miles S-E of Chalchicomula
(distance) (direction) (nearest town)

WELL PURPOSE: home
(home, irrigation, municipal, industrial)

- WELL COMPLETION DATA:
- (1) diameter (inches) 4
 - (2) total depth (feet) 185
 - (3) static water level (feet) 108 below above top of ground.
 - (4) casing P.V.C. 185
(material) (depth)
(size) if telescope see back.
 - (5) screen 10 175
(length) (depth to top)
4" P.V.C.
(size) (material)
 - (6) pump 3/4 12
(HP) (yield gpm)
elec.
(type power)
 - (7) electric log yes or no
(organization running log)
 - (8) how well bottom plugged CAP

CODED


MAR 6 1970

MISS. BD. OF
WATER COMM.

DRILLERS REMARKS:

If well telescopes please sketch and show depths.

GROUND LEVEL

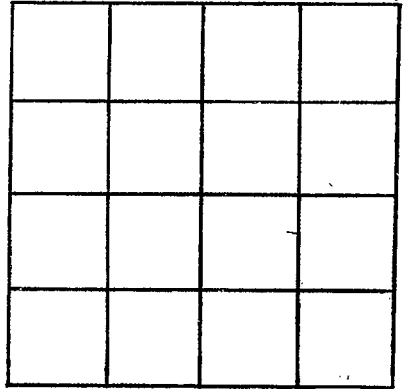

SECTION _____

Please indicate well location X.

ADDITIONAL INFORMATION

If more than one screen,
show locations of each on sketch.