

Marshall Co
R 14

MISSISSIPPI
 BOARD OF WATER COMMISSIONERS
 416 North State Street
 Jackson, Mississippi 39201

COPIED

WATER WELL DRILLERS LOG


19 Atkinson & East firm name Marshall county well located

LANDOWNER:	description of formations encountered	from	to
<u>Sexton Cox</u>			
<u>R 15 Valley Springs</u> (mailing address)	<u>red sand</u> <u>white sand</u>	<u>0</u> <u>30</u>	<u>30</u> <u>147</u>
WELL LOCATION:			
sec. <u>4</u> T. <u>45</u> N. R. <u>4</u> E. <u>217</u> <u>1</u> miles <u>E</u> of <u>Shubdon</u> (distance) (direction) (nearest town)			
WELL PURPOSE: (home, irrigation, municipal, industrial)			
WELL COMPLETION DATA:			
(1) diameter (inches) <u>4 1/2"</u>			
(2) total depth (feet) <u>147</u>			
(3) static water level (feet) <u>90</u> below top of ground.			
(4) casing <u>P.V.C.</u> , <u>137</u> , (material) (depth)			
_____ if telescope see back. (size)			
(5) screen <u>40</u> , <u>137</u> (length) (depth to top)			
<u>4"</u> , <u>P.V.C.</u> (size) (material)			
(6) pump <u>3/4</u> , <u>12</u> (HP) (yield gpm)			
_____ (type power)			
(7) electric log _____ (yes or no)			
_____ (organization running log)			
(8) how well bottom plugged <u>CAP.</u>			
DRILLERS REMARKS:			

MAY 7 8 1970
 MISS. BD. OF
 WATER COMMISSIONERS

If well telescopes please sketch and show depths.

GROUND LEVEL

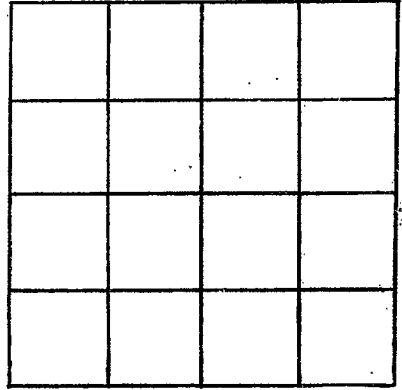

SECTION _____

Please indicate well location X.

ADDITIONAL INFORMATION

If more than one screen, show locations of each on sketch.