

**MARSHALL**  
**R 15**  
**70**

MISSISSIPPI  
 BOARD OF WATER COMMISSIONERS  
 416 North State Street  
 Jackson, Mississippi 39201

**CODED**

**WATER WELL DRILLERS LOG**

*Atkinson & Frost* *MARSHALL*

date well completed \_\_\_\_\_ firm name \_\_\_\_\_ county well located \_\_\_\_\_

LANDOWNER: *Easter Muse*  
*R#5*  
*Holly Spring & Miss*  
 (mailing address)

| description of formations encountered | from       | to         |
|---------------------------------------|------------|------------|
| <i>CLAY CRIT</i>                      | <i>0</i>   | <i>10</i>  |
| <i>COARSE WHITESAND</i>               | <i>10</i>  | <i>200</i> |
| <i>WHITE CLAY</i>                     | <i>200</i> | <i>215</i> |
| <i>WHITE SAND</i>                     | <i>215</i> | <i>235</i> |

WELL LOCATION:  
 sec. 4 T. 5 N. R. 4 E.  
 3 miles W of Chulahoma  
 (distance) (direction) (nearest town)

WELL PURPOSE:  
 (home, irrigation, municipal, industrial)

- WELL COMPLETION DATA:
- (1) diameter (inches) 4"
  - (2) total depth (feet) 255'
  - (3) static water level (feet) 210 below top of ground.
  - (4) casing P.V.C., 245'  
 (material) (depth)  
 (size) if telescope see back.
  - (5) screen 10', 245'  
 (length) (depth to top)  
4", P.V.C. + SAND  
 (size) (material)
  - (6) pump 3/4 10  
 (HP) (yield gpm)  
Elec.  
 (type power)
  - (7) electric log \_\_\_\_\_  
 (yes or no)  
 \_\_\_\_\_  
 (organization running log)
  - (8) how well bottom plugged CAP.

**CODED**


OCT 13 1970

DRILLERS REMARKS:

MISS. BD. OF  
 WATER COMM.

If well telescopes please sketch and show depths.

GROUND LEVEL

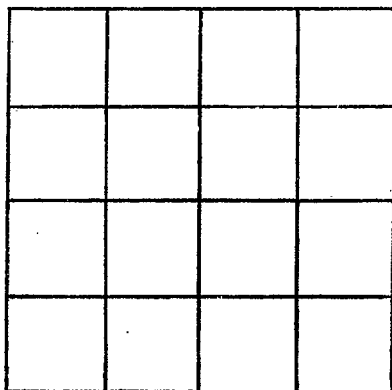

SECTION \_\_\_\_\_

Please indicate well location X.

ADDITIONAL INFORMATION

If more than one screen,  
show locations of each on sketch.