

MARSHALL

R16

70

MISSISSIPPI BOARD OF WATER COMMISSIONERS
416 North State Street
Jackson, Mississippi 39201

CODED

WATER WELL DRILLERS LOG

A. Keison & Son *Marshall*

date well completed

firm name

county well located

LANDOWNER: *Wesley King*

description of formations encountered

from

to

Holly Springs Miss
(mailing address)

Clay Red

0

10

Red SAND

10

50

White SAND

50

155

WELL LOCATION:

sec. *4* T. *3* N. R. *4* E.
1 1/2 miles *SE* of *Chokoma*
(distance) (direction) (nearest town)

WELL PURPOSE: *home*
(home, irrigation, municipal, industrial)

WELL COMPLETION DATA:

- (1) diameter (inches) *4"*
- (2) total depth (feet) *155*
- (3) static water level (feet) *122* below above top of ground.
- (4) casing *PVC, 155*
(material) (depth)
(size) If telescope see back.
- (5) screen *10' 145*
(length) (depth to top)
4" P.O.C. + SAND
(size) (material)
- (6) pump *3/4 12*
(HP) (yield gpm)
Elec.
(type power)
- (7) electric log (yes or no)

(organization running log)

(8) how well bottom plugged *CAP.*

CODED


OCT 13 1970

DRILLERS REMARKS:

MISS. BD. OF WATER COMMISSIONERS

If well telescopes please sketch and show depths.

GROUND LEVEL

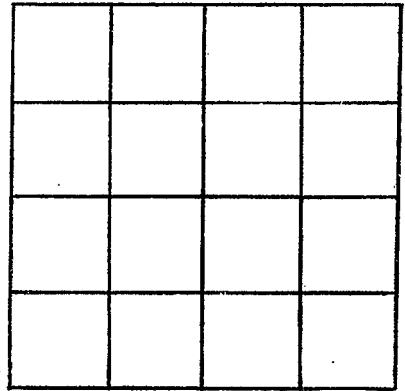

SECTION _____

Please indicate well location X.

ADDITIONAL INFORMATION

If more than one screen, show locations of each on sketch.