

MARSHALL
R 18
12-1-70

MISSISSIPPI
 BOARD OF WATER COMMISSIONERS
 416 North State Street
 Jackson, Mississippi 39201

CODED

WATER WELL DRILLERS LOG

12/1/70 19 Thorpe Well Supply Co. Marshall
 date well completed firm name county well located

LANDOWNER: L.E. Darsanburg

Holly Springs Miss.

Route 5
 (mailing address)

WELL LOCATION:

sec. 36 T 5 S R 4 W
 11 miles W of Holly Springs
 (distance) (direction) (nearest town)

WELL PURPOSE:

(home, irrigation, municipal, industrial)

WELL COMPLETION DATA:

- (1) diameter (inches) 4"
- (2) total depth (feet) 240
- (3) static water level (feet) 220 below above-top of ground.
- (4) casing PVC(NSF) 240 (material) (depth)
 (size) if telescope see back.
- (5) screen 5' 240 (length) (depth to top)
 30 Slatod (size) (material)
- (6) pump 3/4 10 (HP) (yield gpm)
 220 SP (type power)
- (7) electric log No (yes or no)

(organization running log)

(8) how well bottom plugged Cap at bottom of string

description of formations encountered

from to

top soil	0	5
red sand + clay	5	34
white clay	34	50
course grey sand	50	71
course white sand	71	73
med white sand	73	75
med course white sand	75	159
course white sand	159	170
course white sand	170	240

CODED


JAN 25 1971

DRILLERS REMARKS:

MISS. BD. OF
 WATER COMM.

If well telescopes please sketch and show depths.

GROUND LEVEL

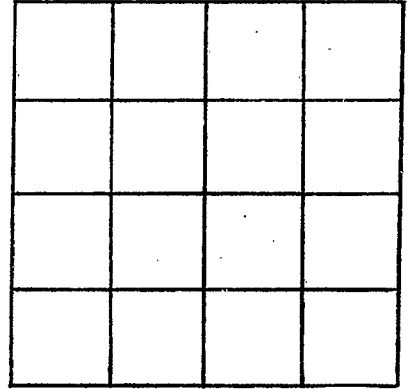

SECTION _____

Please indicate well location X.

ADDITIONAL INFORMATION

If more than one screen,
show locations of each on sketch.