

**MARSHALL**  
**R 20**  
**3-28-72**

MISSISSIPPI  
 BOARD OF WATER COMMISSIONERS  
 416 North State Street  
 Jackson, Mississippi 39201

**CODED**

WATER WELL DRILLERS LOG

Mar. 28 1972 R. L. Carpenter Marshall  
 date well completed firm name county well located

LANDOWNER: Galena School  
Holly Springs, Miss  
RFD  
 (mailing address)

WELL LOCATION:  
 sec. 12 T 5 N R 4 E  
 (distance) miles 4 (direction) East of Chalahoma (nearest town)

WELL PURPOSE: School  
 (home, irrigation, municipal, industrial)

WELL COMPLETION DATA:

(1) diameter (inches) 4

(2) total depth (feet) 230

(3) static water level (feet) 168 below top of ground.

(4) casing Plastic 218 ft.  
 (material) (depth)

(size) If telescope see back.

(5) screen 12 218 ft.  
 (length) (depth to top)

4 in. Plastic & Sand  
 (size) (material)

(6) pump 2 25  
 (HP) (yield gpm)

Elec.  
 (type power)

(7) electric log No  
 (yes or no)

(organization running log)

(8) how well bottom plugged Plastic Plug

description of formations encountered	from	to
Surface Soil	0	21
Med. Red Sand	21	52
Med. & Fine white Sand	52	96
White Clay	96	118
Med. white sand	118	175
White coarse sand	175	230

**CODED**


APR 4 1972

MISS. BD. OF WATER COM.

DRILLERS REMARKS:

If well telescopes please sketch and show depths.

GROUND LEVEL

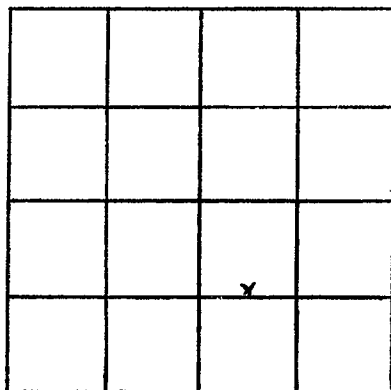

SECTION 12

Please indicate well location X.

ADDITIONAL INFORMATION

If more than one screen,  
show locations of each on sketch.