

MARSHALL  
R 21  
7-21-72

MISSISSIPPI  
BOARD OF WATER COMMISSIONERS  
416 North State Street  
Jackson, Mississippi 39201

**CODED**

WATER WELL DRILLERS LOG

July 21 1972 R. L. Carpenter Marshall  
date well completed firm name county well located

LANDOWNER: W. R. Patton  
Red Rocks, Miss  
RFD  
(mailing address)

| description of formations encountered | from | to  |
|---------------------------------------|------|-----|
| Surface Soil                          | 0    | 12  |
| Brown med Sand                        | 12   | 24  |
| white fine sand                       | 24   | 60  |
| white clay                            | 60   | 72  |
| med white sand                        | 72   | 120 |
| white coarse sand                     | 120  | 148 |

WELL LOCATION:  
sec. 18 T 3 N R 4 E  
1 miles East of Victoria  
(distance) (direction) (nearest town)

WELL PURPOSE: Home  
(home, irrigation, municipal, industrial)

- WELL COMPLETION DATA:
- (1) diameter (inches) 4
  - (2) total depth (feet) 148
  - (3) static water level (feet) 118 below above top of ground.
  - (4) casing Plastic, 142 ft.  
(material) (depth)  
(size) if telescope see back.
  - (5) screen 6 ft, 142 ft  
(length) (depth to top)  
4 in Plastic & gravel  
(size) (material)
  - (6) pump 3/4, 10  
(HP) (yield gpm)  
Chs.  
(type power)
  - (7) electric log No  
(yes or no)  
(organization running log)
  - (8) how well bottom plugged Plastic Plug


**CODED**

MISS - 4 1972

DRILLERS REMARKS: \_\_\_\_\_

If well telescopes please sketch and show depths.

GROUND LEVEL

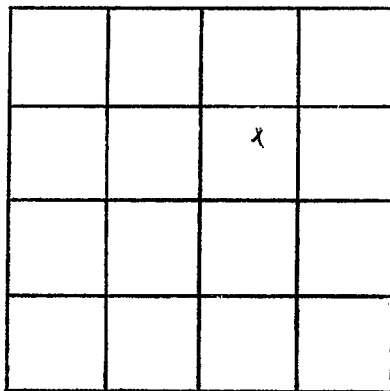

SECTION 10

Please indicate well location X.

ADDITIONAL INFORMATION

If more than one screen, show locations of each on sketch.