

MARSHALL
R 22
12-72

MISSISSIPPI
 BOARD OF WATER COMMISSIONERS
 416 North State Street
 Jackson, Mississippi 39201

CODED

WATER WELL DRILLERS LOG

Atkinson Frost **MARSHALL**

date well completed 19 12 firm name Atkinson Frost county well located MARSHALL

LANDOWNER: W. H. A. Burton
Holly Springs.
 (mailing address)

description of formations encountered	from	to
CLAY	0	10
SAND	10	65
White CLAY	65	70
SAND	70	112
White clay	112	120
White sand	120	145

WELL LOCATION:
 sec. 4 T. 5 N. R. 7 E.
 (distance) miles of (direction) of (nearest town)

WELL PURPOSE:
 (home, irrigation, municipal, industrial)

WELL COMPLETION DATA:

- (1) diameter (inches) 4
- (2) total depth (feet) 145
- (3) static water level (feet) 120 below above top of ground.
- (4) casing P.V.C. 120
 (material) (depth)
 (size) If telescope see back.
- (5) screen 10ft 130
 (length) (depth to top)
4" P.V.C.
 (size) (material)
- (6) pump 3/4 10
 (HP) (yield gpm)
1/2 hp.
 (type power)
- (7) electric log
 (yes or no)


 (organization running log)
- (8) how well bottom plugged CAP

DRILLERS REMARKS:

JAN 11 1973

If well telescopes please sketch and show depths.

GROUND LEVEL

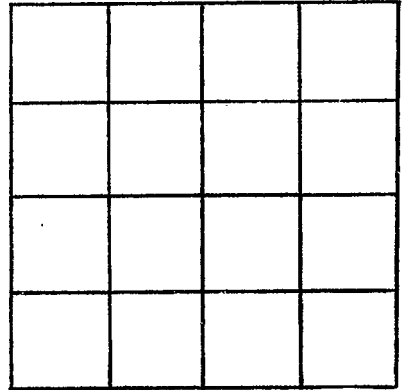

SECTION _____

Please indicate well location X.

ADDITIONAL INFORMATION

If more than one screen, show locations of each on sketch.