

MARSHALL
R 23
8-8-72

MISSISSIPPI
 BOARD OF WATER COMMISSIONERS
 416 North State Street
 Jackson, Mississippi 39201

CODED

WATER WELL DRILLERS LOG

8-8- 1972 Bob Lee Marshall
 date well completed firm name county well located


LANDOWNER:	description of formations encountered	from	to
<u>Jones Bellard</u>	<u>clay lint</u>		<u>10</u>
<u>Wyatt, Miss.</u> (mailing address)	<u>red sand</u>	<u>10</u>	<u>40</u>
WELL LOCATION: sec. <u>19</u> T <u>5</u> N R <u>4</u> E (<u>S</u>) (<u>W</u>) <u>2</u> miles <u>SWS</u> of <u>Chukahoma</u> (distance) (direction) (nearest town)	<u>white sand</u>	<u>40</u>	<u>225</u>
WELL PURPOSE: (home, irrigation, municipal, industrial) <u>Home</u>			
WELL COMPLETION DATA:			
(1) diameter (inches) <u>4</u>			
(2) total depth (feet) <u>225</u>			
(3) static water level (feet) <u>190</u> below above top of ground.			
(4) casing <u>Plastic</u> , <u>225</u> (material) (depth)			
(size) If telescope see back.			
(5) screen <u>20</u> , <u>205</u> (length) (depth to top)			
(size) (material) <u>4</u> , <u>Plastic</u>			
(6) pump <u>1/2</u> , <u>10</u> (HP) (yield gpm)			
(type power) <u>Electric</u>			
(7) electric log <u>no</u> (yes or no)			
(organization running log)			
(8) how well bottom plugged <u>plugged</u>			
DRILLERS REMARKS:			

CODED

FILE 9-8-72

If well telescopes please sketch and show depths.

GROUND LEVEL

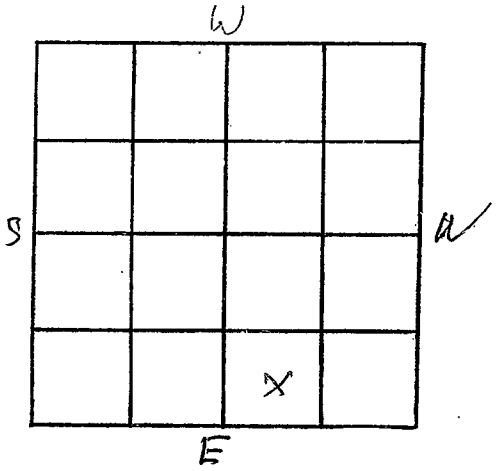

SECTION 19

Please indicate well location X.

ADDITIONAL INFORMATION

A series of horizontal lines for entering additional information.

If more than one screen, show locations of each on sketch.