

MARSHALL
R24
2-28-73

MISSISSIPPI
BOARD OF WATER COMMISSIONERS
416 North State Street
Jackson, Mississippi 39201

CODED

WATER WELL DRILLERS LOG

Feb 28 1973 R.L. Carpenter Marshall
date well completed firm name county well located

LANDOWNER: Bobby Fitch
~~_____~~ Holly Springs, Miss.
R.F.D.
(mailing address)

WELL LOCATION:
sec. 18 T-5 N R-4 E
5 miles north of Levee Hill, Miss.
(distance) (direction) (nearest town)

WELL PURPOSE: Farm
(home, irrigation, municipal, industrial)

- WELL COMPLETION DATA:
- (1) diameter (inches) ~~4~~ 4
 - (2) total depth (feet) 295
 - (3) static water level (feet) 197 below above top of ground.
 - (4) casing Plastic, 282 ft (material) (depth)
 - (size) If telescope see back.
 - (5) screen 13 ft, 282 ft (length) (depth to top)
4 in. Plastic & Travel (size) (material)
 - (6) pump 1 HP, 10 (HP) (yield gpm)
Elec. (type power)
 - (7) electric log No. (yes or no)
 - (organization running log)
 - (8) how well bottom plugged Plastic cap

description of formations encountered	from	to
Surface Soil	0	23
Brown med. sand	23	37
white clay	37	49
white coarse sand	49	90
white clay	90	106
Fine white sand	106	175
med white sand	175	230
white clay	230	243
white coarse sand	243	295


CODED

DRILLERS REMARKS:

JUL 30 1973

If well telescopes please sketch and show depths.

GROUND LEVEL

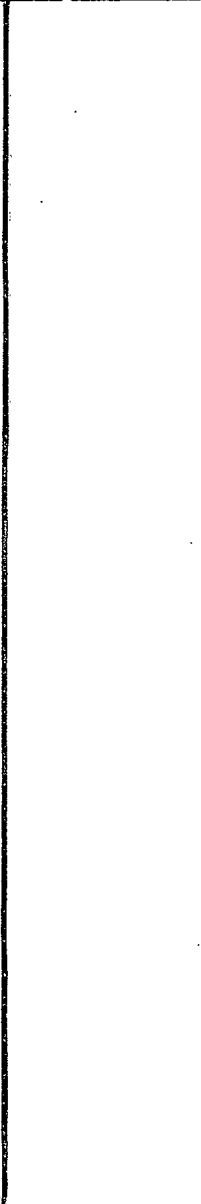

SECTION _____

Please indicate well location X.

ADDITIONAL INFORMATION

If more than one screen,
show locations of each on sketch.