

MARSHALL

CODED

MISSISSIPPI  
BOARD OF WATER COMMISSIONERS  
416 North State Street  
Jackson, Mississippi 39201

MARSHALL

WATER WELL DRILLERS LOG

~~Atkinson & Frost~~

~~Marshall~~

~~DATE~~  
R28  
3/74

19 date well completed

firm name

county well located

LANDOWNER:

Rayward Phillips

(mailing address)

description of formations encountered

from to

Red Clay	0	25
Red Sand	25	100
White Clay	100	130
White Sand	130	185

WELL LOCATION:

sec. 4 T 5 N R 4 E  
2 1/2 miles North West of Chulahor #4  
(distance) (direction) (nearest town)

WELL PURPOSE:

(home, irrigation, municipal, industrial)

WELL COMPLETION DATA:

- (1) diameter (inches) 4 1/2
- (2) total depth (feet) 185
- (3) static water level (feet) 140 below top of ground.
- (4) casing (material) (depth)
- (size) if telescope see back.
- (5) screen 177, 185 (length) (depth to top)
- (size) (material)
- (6) pump 3 (HP) 10 (yield gpm)
- Floor (type power)
- (7) electric log (yes or no)

CODED

(organization running log)


(8) how well bottom plugged

DRILLERS REMARKS:

DEC 1973  
FEB 9

If well telescopes please sketch and show depths.

GROUND LEVEL

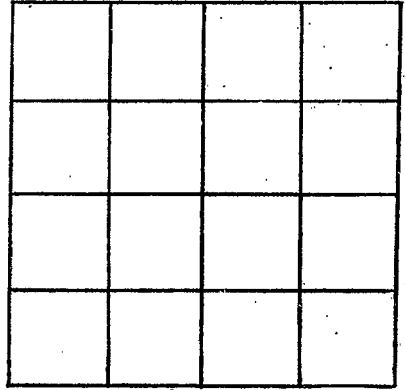

SECTION \_\_\_\_\_

Please indicate well location X.

ADDITIONAL INFORMATION

If more than one screen, show locations of each on sketch.