

MARSHALL

R32

9-25-74

MISSISSIPPI BOARD OF WATER COMMISSIONERS
416 North State Street
Jackson, Mississippi 39201

CODED

WATER WELL DRILLERS LOG

9-25
date well completed

1974 Bob Smith Well Drilling
firm name

Marshall
county well located

LANDOWNER

Shady Spentham

description of formations encountered

from

to

839 (Paw)

top soil

0

20

Memphis Tenn.
(mailing address)

red sand

20

100

white sand - actually 100

white fine sand

180

200

concrete sand

200

245

WELL LOCATION:

sec 29 T 5 N R 4 E
3 miles SW of Chickahominy
(distance) (direction) (nearest town)

WELL PURPOSE: Home
(home, irrigation, municipal, industrial)

WELL COMPLETION DATA:

- (1) diameter (inches) 4
- (2) total depth (feet) 245'
- (3) static water level (feet) 150' below top of ground.
- (4) casing plastic, 245' (material) (depth)
- (size) if telescope see back.
- (5) screen 10' 245' (length) (depth to top)
- 4" plastic (size) (material)
- (6) pump 1/2 10 (HP) (yield gpm)
- electric (type power)
- (7) electric log no (yes or no)

(organization running log)


(8) how well bottom plugged plugged

DRILLERS REMARKS:

OCT 23 1974

If well telescopes please sketch and show depths.

GROUND LEVEL

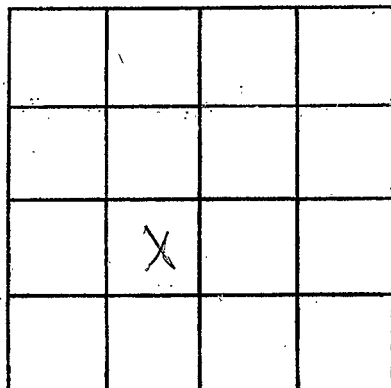

SECTION _____

Please indicate well location X.

ADDITIONAL INFORMATION

If more than one screen,
show locations of each on sketch.