

CODED

MARSHALL
R 33
10/79

MISSISSIPPI
BOARD OF WATER COMMISSIONERS
416 North State Street
Jackson, Mississippi 39201

CODED

WATER WELL DRILLERS LOG

Atkinson & Frost *Marshall*

date well completed 19 10 firm name Atkinson & Frost county well located Marshall

LANDOWNER:
Issac James


(mailing address)

| description of formations encountered | from | to |
|---------------------------------------|------|-----|
| Clay | 0 | 18 |
| Red sand & white | 18 | 140 |
| white clay | 140 | 165 |
| Clay & Sand Mix | 165 | 200 |
| white sand | 200 | 240 |

WELL LOCATION:
sec. 4 T 5 N R 4 E
5 miles N.W. of Chalahoma
(distance) (direction) (nearest town)

WELL PURPOSE:
(home, irrigation, municipal, industrial)

- WELL COMPLETION DATA:
- (1) diameter (inches) 4 1/2
 - (2) total depth (feet) 240
 - (3) static water level (feet) 200 below above top of ground.
 - (4) casing POC 230
(material) (depth)
 If telescope see back.
(size)
 - (5) screen 10 240
(length) (depth to top)
 (size) (material)
 - (6) pump 3/4 10
(HP) (yield gpm)
Ellec
(type power)
 - (7) electric log no
(yes or no)
 (organization running log)
 - (8) how well bottom plugged Cop

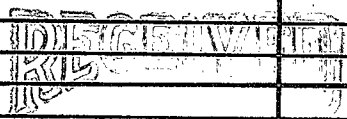


NEW - 7 1974

DRILLERS REMARKS:

If well telescopes please sketch and show depths.

GROUND LEVEL

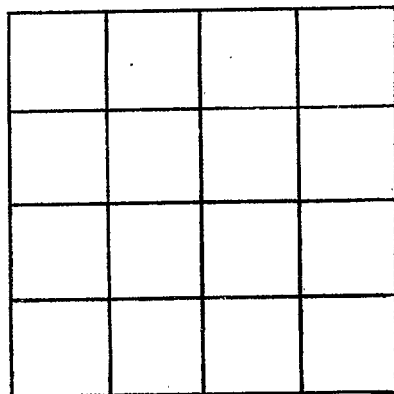

SECTION _____

Please indicate well location X.

ADDITIONAL INFORMATION

If more than one screen, show locations of each on sketch.