

MISSISSIPPI DEPARTMENT OF NATURAL RESOURCES

Bureau of Land and Water Resources

Southport Mall

P.O. Box 10631

Jackson, Mississippi 39209

WATER WELL DRILLERS LOG

CODED

Marshall
R 35
4-6-81

4-6-1981 date well completed Hicks Well Co firm name Marshall county well located

LANDOWNER: Hoge, Shawn
Rt. 5
Holly Springs, Mo.
(mailing address)


description of formations encountered	from	to
<u>Red Clay</u>	<u>0</u>	<u>10</u>
<u>Red Sand</u>	<u>10</u>	<u>15</u>
<u>White sand</u>	<u>15</u>	<u>182</u>

WELL LOCATION:
sec. 9 T. 5 N. R. 4 E.
3 S. W
1 miles (distance) Chalahoma (direction) (nearest town)

WELL PURPOSE: Home
(home, irrigation, municipal, industrial)

- WELL COMPLETION DATA:
- (1) diameter (inches) 4
 - (2) total depth (feet) 182
 - (3) static water level (feet) 140 below top of ground.
 - (4) casing PVC (material) 182 (depth)
If telescope see back.
(size)
 - (5) screen 12 (length) 170 (depth to top)
4" (size) Apex (material)
 - (6) pump 3/4 (HP) 18 (yield gpm)
220V (type power)
 - (7) electric log No (yes or no)
(organization running log)
 - (8) how well bottom plugged Cap

DRILLERS REMARKS:

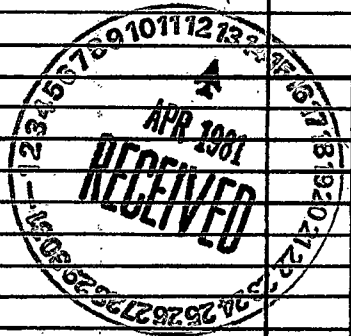

DEPT. OF NATURAL RESOURCES
BUREAU OF LAND & WATER RESOURCES

APR 13 1981

RECEIVED

If well telescopes please sketch and show depths.

GROUND LEVEL

X			

SECTION 9

Please indicate well location X.

ADDITIONAL INFORMATION

If more than one screen, show locations of each on sketch.