

19-0883

STATE WELL REPORT

347

County: Marshall
 Permit #: GW-17452
 Driller: Rodney Tolson
 Date drilling completed: 10-6-2020

Part I
 Driller's Log
 Mississippi Department of Environmental Quality
 Office of Land and Water Resources
 P.O. Box 2309
 Jackson, MS 39225-2309
 (601)961-5555
 (601)961-5228 (fax)

For Office Use Only:
 Well #: R 75
 Aquifer: _____
 E-Log #: _____

State Law requires that this report be prepared by the license holder responsible for the work and filed with the Department at the above address within 30 days of completion of drilling of the well or borehole.

Well Owner Information <i>(Landowner if borehole is not for a water well)</i>	Well or Borehole Location
Owner Name: <u>Robert L. Woods</u>	Latitude: <u>34.748359</u> Longitude: <u>89.623514</u>
Mailing Address: <u>Po Box 5067</u>	<u>34.639504</u> <u>-89.637497</u>
<u>Holly Springs</u> <u>MS</u> <u>38634</u>	Method of Lat/Long (check one): Conventional Survey _____
City State Zip Code	USGS quad _____, Hand-held GPS <input checked="" type="checkbox"/> , Survey-grade GPS _____
Telephone No. <u>(662) 274-5173</u>	<u>NE</u> <u>1/4</u> <u>NE</u> <u>1/4</u> , Sec <u>20</u> T <u>5S</u> R <u>4W</u>
	<u>10.14</u> Miles <u>W</u> of <u>Holly Springs, MS.</u>
	(Distance) (Direction) (Nearest Town)

Well / Borehole Data

Date drilling started: 10-6-2020 Date drilling completed: 10-6-2020 Hole depth: 175 Hole diameter: _____

Location of the source of any surface water used for drilling: used ground water (shop well)

Method of dosing and volume of Chlorine used in drilling and development: 15 pounds of 70% bleach

Logs run (check all applicable): log run Electric Gamma Ray Density Sonic Neutron Other: _____

Name of organization running log(s): _____

Purpose of borehole (check one): Water Well Geotechnical/Geological Investigation Ground Source Heat Pump Seismic Survey Other (describe) _____

If drilling is not related to water well construction, skip the remainder of this block

Purpose of Well (check all applicable): Home Industrial Public Supply Irrigation Fish Culture

Other (describe): _____

If a flowing well, method of flow regulation: Valve _____ Other (describe) _____

Static Water Level: 10 ft feet above or below land surface Date measured: 10-7-2020
(check one)

Method of measurement (check one) Steel tape Electric tape Air line Other (describe): _____

Well depth: 175 Well grouted to a depth of: 10 feet Type of grout (check one) Neat Cement Bentonite Mix

Casing length: 135 feet Casing diameter: 12 inches Type of casing: PVC

Screen length: 40 feet Screen diameter: 12 inches Type of screen: PVC

Screen slot size: .020 inches Setting depth: From _____ feet to _____ feet

Type of completion (check all applicable) gravel packed Underreamed Open hole Natural Development

Other (describe): _____

Top of lap pipe or reduction in casing: _____ feet

If telescoped or more than one screen, describe on next page

RECEIVED
 OCT 14 2020
 BY OLWR

Form: OLWR-SWR-1A (4/13)

19-0883

STATE OF MISSISSIPPI

Department of Environmental Quality
Office of Land and Water Resources
P.O.Box 2309
Jackson, Mississippi 39225

Union Valley rd

19-0883

**PERMIT
TO DIVERT OR WITHDRAW FOR BENEFICIAL USE THE PUBLIC WATERS**

This permit is issued to the landowner named below in accordance with the provisions of the Mississippi Water Laws, Mississippi Code Sections 51-3-1, et seq.(1972, as amended), and the regulations and standards as promulgated thereunder. Whether or not specifically named in this permit or in the applications for this permit, anyone using water from the diversion/withdrawal point described below shall do so in compliance with the provisions of this permit. Neither this permit, nor any authority conferred hereby, may be sold, conveyed, encumbered, assigned or otherwise aliened, for any period of time or under any conditions whatsoever. This permit may not be modified, transferred, or revoked without prior action by the Permit Board. Any attempts to modify, transfer or revoke this permit, or to take any other action on this permit, shall be invalid and unenforceable and may result in immediate revocation or suspension of this permit. The holder of this permit shall at all times be responsible for adherence to the terms and conditions of this permit. No agreement between the permit holder and any other party shall affect the obligations and liabilities of the permit holder. Water use under this permit is allowed only when the streamflow or lake level elevation (whichever, if any, is applicable) is above the established minimum, pursuant to Mississippi Code Section 51-3-7. Authorization is hereby granted to divert/withdraw water for the beneficial use designated herein, and for no other purpose, subject to the following terms, conditions, and limitations:

Permit Number: MS-GW-17452

Landowner Name: WOODS, ROBERT L
Landowner Address: PO BOX 5067
HOLLY SPRNGS, MS 38634

Source of Water: MERIDIAN-UPPER WILCOX AQUIFER

Beneficial Use(s): IRRIGATION

Diversion/Withdrawal Location: NE 1/4 of the NE 1/4 Section: 20 Township: 05S Range: 04W

County: MARSHALL Quad: WYATTE

Permitted Volume: Annual: 105.0000 Acre-feet equivalent to Daily: 0.0937 Million Gallons

Maximum Pumping Rate: 500.00 Gallons/Minute

Applicant Name: WOODS, ROBERT L
Applicant Address: PO BOX 5067
HOLLY SPRNGS, MS 38634

Date Permit Issued: 10/21/2019

Date Permit Expires: 10/21/2029

Date Permit Modified:

Date Permit Reissued:

This permit shall be deemed null and void if construction has not begun within one (1) year of permit issue date.

SPECIAL TERMS AND CONDITIONS I:

See Attachment I which is hereby declared part of this permit.


**RECEIVED
OCT 14 2020
BY OLWR**


Gary C. Rikard Executive Director
Mississippi Department of Environmental Quality

Drive 88.9 miles, 1 h 37 min

420 Rain St, Clarksdale, MS to Holly Springs School District, Mississippi

Google Maps

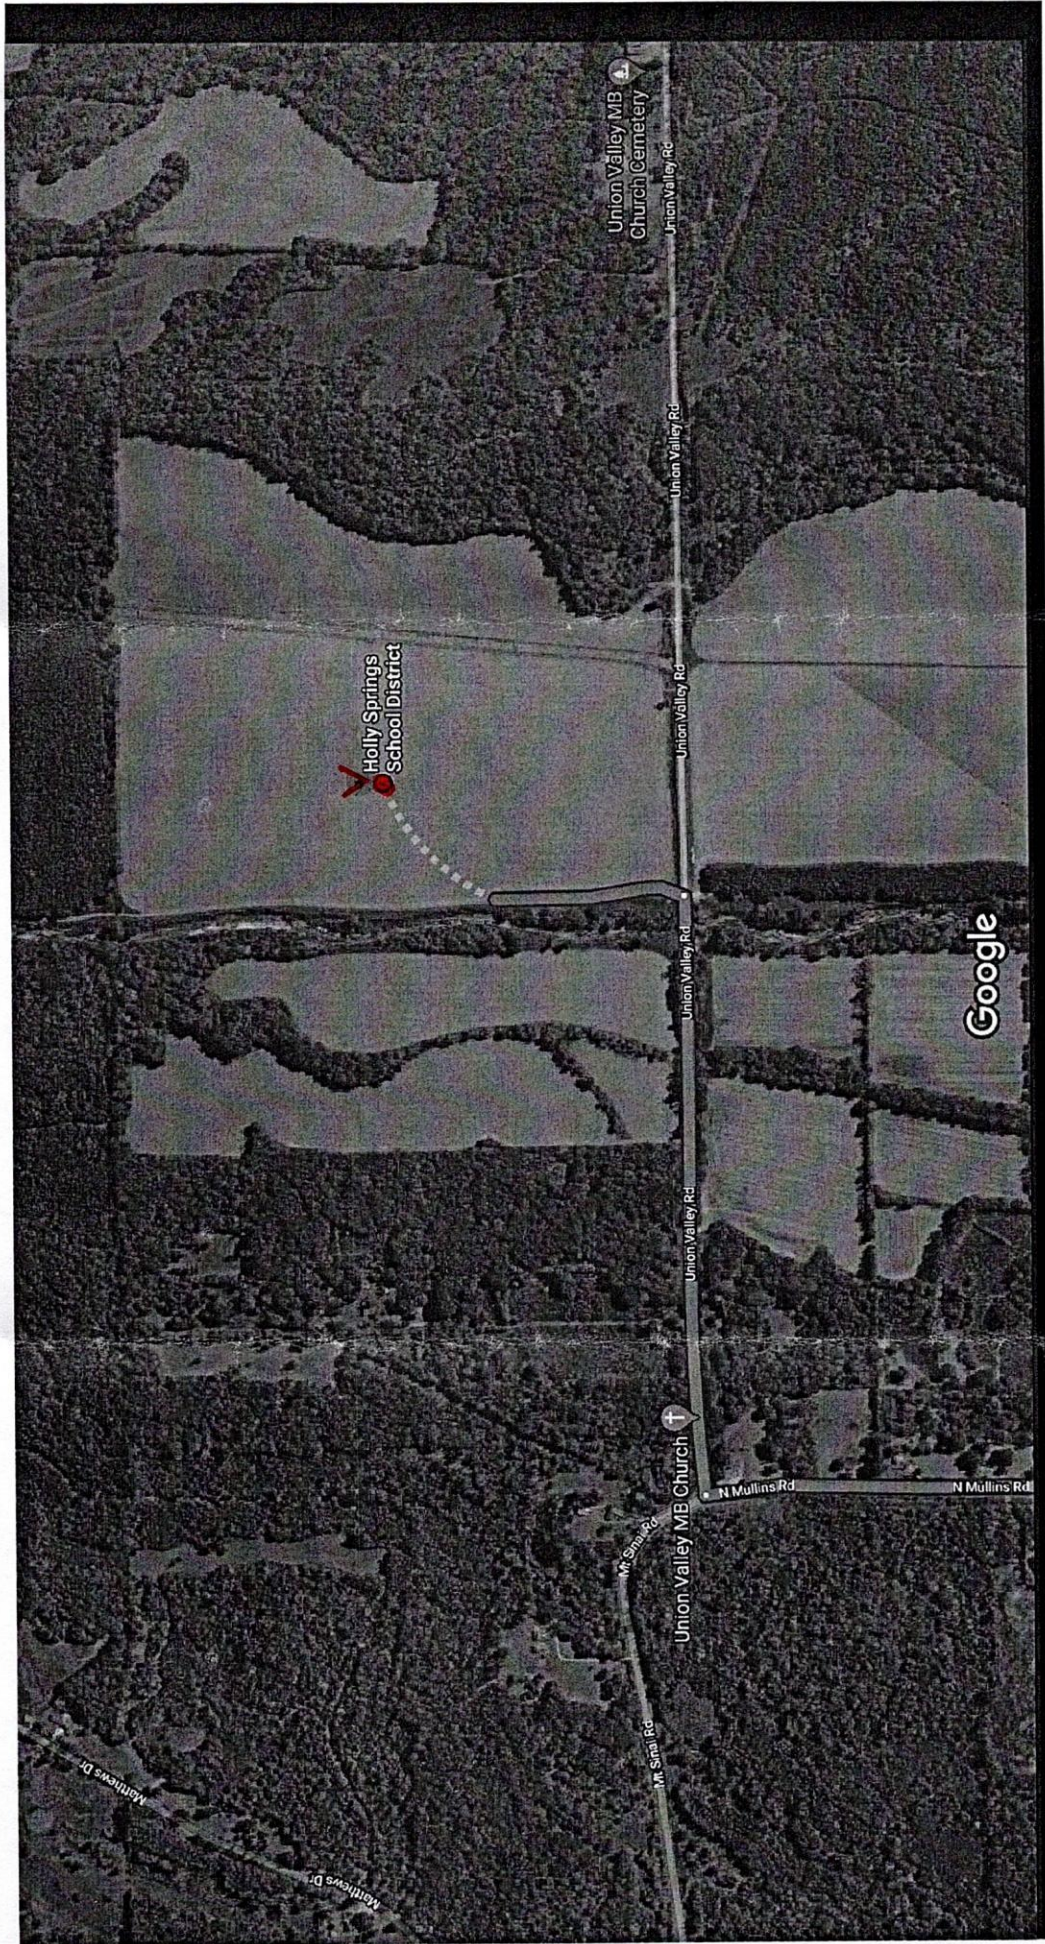

Imagery ©2020 Maxar Technologies, State of Arkansas, USDA Farm Service Agency, Map data ©2020

500 ft

1 h 37 min
88.9 miles

via US-61 N and MS-4 E
Best route



1 h 36 min

via MS-6 E



RECEIVED
OCT 14 2020
BY DLW