

MARSHALL

R 2002

8-27-76

MISSISSIPPI BOARD OF WATER COMMISSIONERS
416 North State Street
Jackson, Mississippi 39201

WATER WELL DRILLERS LOG

Aug. 27 1976

R. L. Carpenter

Marshall

date well completed

firm name

county well located

LANDOWNER: Marshall County

Chalofona Community Center

Chalofona, Miss.

(mailing address)

description of formations encountered

from

to

Surface Soil

0

23

Red Brown Sand

23

38

Red & Fine White Sand

38

95

White Clay

95

130

White coarse sand

130

170

WELL LOCATION:

sec. 16 T-5 N R-4 E
1 miles East of Chalofona
(distance) (direction) (nearest town)

WELL PURPOSE: Common Center
(home, irrigation, municipal, industrial)

WELL COMPLETION DATA:

- (1) diameter (inches) 4
- (2) total depth (feet) 170
- (3) static water level (feet) 105 below above top of ground.
- (4) casing Plaster 164' (material) (depth)
- (size) if telescope see back.
- (5) screen 6' 164' (length) (depth to top)
- 1/4" Plaster Screen (size) (material)
- (6) pump 3/4 10 (HP) (yield gpm)
- Elec. (type power)
- (7) electric log No (yes or no)

(organization running log)

(8) how well bottom plugged Plaster cap


DRILLERS REMARKS:

RECEIVED
MAY 12 1978

MISS. BD. OF WATER COMMISSIONERS

If well telescopes please
sketch and show depths.

GROUND LEVEL

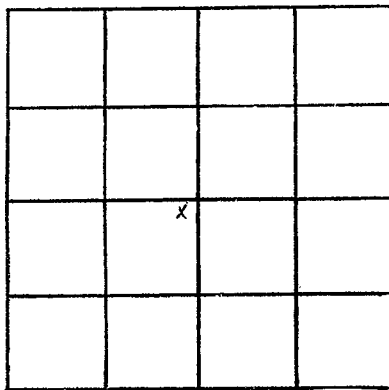

SECTION 16

Please indicate well location X.

ADDITIONAL INFORMATION

If more than one screen,
show locations of each on sketch.