

Marshall
R 2003
3-11-77

MISSISSIPPI
 BOARD OF WATER COMMISSIONERS
 416 North State Street
 Jackson, Mississippi 39201

15F

WATER WELL DRILLERS LOG

date well completed 3-11-77 firm name Rich Well Co. county well located Marshall

LANDOWNER: <u>Elma Hall</u>	description of formations encountered	from	to
<u>Holly Springs, Miss.</u> (mailing address)	<u>Red Clay</u>	<u>0</u>	<u>40</u>
	<u>Red Sand</u>	<u>40</u>	<u>120</u>
	<u>White Clay</u>	<u>120</u>	<u>130</u>
	<u>White Sand</u>	<u>130</u>	<u>145</u>

WELL LOCATION:
 sec. 5 T. 5 N. R. 4 E.
1 miles S of Chula Vista
 (distance) (direction) (nearest town)

WELL PURPOSE: Home
 (home, irrigation, municipal, industrial)

WELL COMPLETION DATA:

- (1) diameter (inches) 4
- (2) total depth (feet) 145
- (3) static water level (feet) 120 below top of ground.
- (4) casing PVC, 145
 (material) (depth)
- (size) if telescope see back.
- (5) screen 7, 138
 (length) (depth to top)
- 4", Drum Type
 (size) (material)
- (6) pump 1/2, 10
 (HP) (yield gpm)
- 220V
 (type power)
- (7) electric log No
 (yes or no)

(organization running log)

(8) how well bottom plugged Cap


DRILLERS REMARKS:

RECEIVED
 APR 8 1977

MISS. BD. OF WATER COMMISSIONERS

If well telescopes please sketch and show depths.

GROUND LEVEL

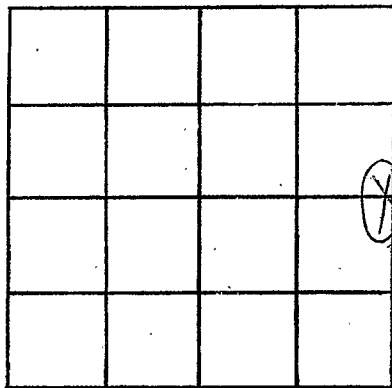

SECTION 20

Please indicate well location X.

ADDITIONAL INFORMATION

If more than one screen, show locations of each on sketch.