

Marshall
R 2004
3-14-77

MISSISSIPPI
BOARD OF WATER COMMISSIONERS
416 North State Street
Jackson, Mississippi 39201

WATER WELL DRILLERS LOG

3-14 1977 date well completed
77 Nicks Well Co. firm name
Marshall county well located

LANDOWNER: Joe Parks
Rt. 5
Holly Springs, Ms.
(mailing address)

WELL LOCATION:
sec. 13 T. 5 N. R. 4 E.
1 miles W of Baldwins
(distance) (direction) (nearest town)

WELL PURPOSE: Home
(home, irrigation, municipal, industrial)

WELL COMPLETION DATA:
(1) diameter (inches) 4"
(2) total depth (feet) 280
(3) static water level (feet) 145 below above top of ground.
(4) casing PVC, 280, (material) (depth)
(size) If telescope see back.
(5) screen 2ft, 273ft. (length) (depth to top)
4" Dravel Type (size) (material)
(6) pump 3/4 10 (HP) (yield gpm)
220V (type power)
(7) electric log No (yes or no)
(organization running log)
(8) how well bottom plugged Cap

description of formations encountered	from	to
Red Clay	0	20
Red Sand	20	40
White Sand	40	220
White Sand & Clay	220	250
White Sand	250	280


DRILLERS REMARKS:

RECEIVED
APR 8 1977

MISS. RD. OF WATER COMMISSIONERS

If well telescopes please sketch and show depths.

GROUND LEVEL

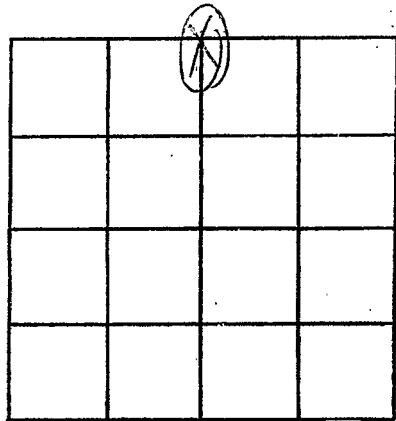

SECTION 13

Please indicate well location X.

ADDITIONAL INFORMATION

If more than one screen, show locations of each on sketch.