

MARSHALL
R 2006
4-27-77

MISSISSIPPI
 BOARD OF WATER COMMISSIONERS
 416 North State Street
 Jackson, Mississippi 39201

WATER WELL DRILLERS LOG

4-27 1977 *Kick Wells Co.* *Marshall*
 date well completed firm name county well located

LANDOWNER: *Stella Faulkner*
Rt. 3, Box 76
Kelly Springs, Ms. 38633
 (mailing address)

description of formations encountered	from	to
<i>Red clay</i>	<i>0</i>	<i>10</i>
<i>white clay</i>	<i>10</i>	<i>45</i>
<i>white clay + sand</i>	<i>45</i>	<i>65</i>
<i>white sand</i>	<i>65</i>	<i>150</i>

WELL LOCATION:
 sec. 3 T 5 N R 4 E
2 miles N of Chula Vista
 (distance) (direction) (nearest town)

WELL PURPOSE: *home*
 (home, irrigation, municipal, industrial)

- WELL COMPLETION DATA:
- (1) diameter (inches) 4
 - (2) total depth (feet) 150
 - (3) static water level (feet) 60 below above top of ground.
 - (4) casing PVC 150
 (material) (depth)
 (size) if telescope see back.
 - (5) screen 7' 143'
 (length) (depth to top)
4" gravel type
 (size) (material)
 - (6) pump 1/2 107
 (HP) (yield gpm)
220V
 (type power)
 - (7) electric log No
 (yes or no)
 - (organization running log)
 - (8) how well bottom plugged Cap


DRILLERS REMARKS:

RECEIVED
 MAY 13 1977

MISS. BD. OF WATER COMMISSIONERS

If well telescopes please sketch and show depths.

GROUND LEVEL

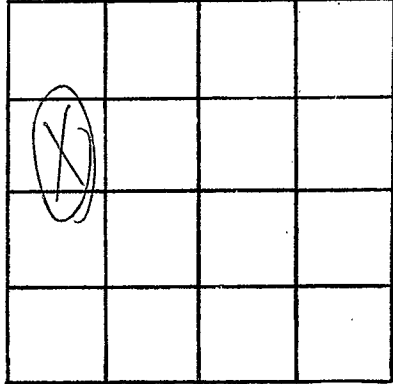

SECTION 3

Please indicate well location X.

ADDITIONAL INFORMATION

If more than one screen, show locations of each on sketch.