

MARSHALL
R 2007
4-29-77

MISSISSIPPI
 BOARD OF WATER COMMISSIONERS
 416 North State Street
 Jackson, Mississippi 39201

15F

WATER WELL DRILLERS LOG

4-29-77 Stick Well Co. Marshall
 date well completed firm name county well located

LANDOWNER: Raymond Patrick
Holly Springs, Ms.
38635
 (mailing address)

description of formations encountered	from	to
<u>Red Clay</u>	<u>0</u>	<u>20</u>
<u>Red Clay + Sand</u>	<u>20</u>	<u>40</u>
<u>Red Sand</u>	<u>40</u>	<u>120</u>
<u>White Sand</u>	<u>120</u>	<u>195</u>

WELL LOCATION:
 sec. 16 T 5 N R 4 E
— miles — of Chulahoma
 (distance) (direction) (nearest town)

WELL PURPOSE: Home
 (home, irrigation, municipal, industrial)

- WELL COMPLETION DATA:
- (1) diameter (inches) 4
 - (2) total depth (feet) 195
 - (3) static water level (feet) 115 below above top of ground.
 - (4) casing PVC 195
 (material) (depth)
 - (size) If telescope see back.
 - (5) screen 7' 188'
 (length) (depth to top)
 - 4" gravel type
 (size) (material)
 - (6) pump 5 30
 (HP) (yield gpm)
 - 220V
 (type power)
 - (7) electric log No
 (yes or no)
 - (organization running log)
 - (8) how well bottom plugged Cap


DRILLERS REMARKS:

RECEIVED
 MAY 28 1977

MISS. BD. OF WATER COMMISSIONERS

If well telescopes please sketch and show depths.

GROUND LEVEL

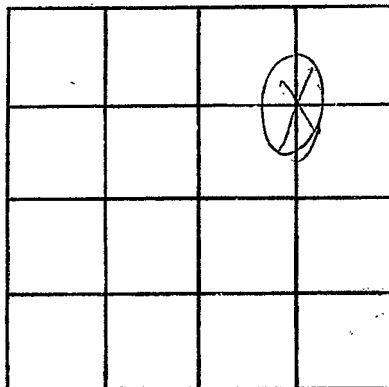

SECTION 16

Please indicate well location 'X'.

ADDITIONAL INFORMATION

If more than one screen, show locations of each on sketch.