

Marshall  
R 2008  
10/24/77

MISSISSIPPI  
BOARD OF WATER COMMISSIONERS  
416 North State Street  
Jackson, Mississippi 39201

WATER WELL DRILLERS LOG

10-24 1977 date well completed  
Hick Well Co. firm name  
Marshall county well located

LANDOWNER: Mack Potter  
description of formations encountered  
from to  
Rt. 3  
Holley Springs, Ms. (mailing address)  
Red clay 0 15  
Red sand + clay 15 130  
white sand 130 180

WELL LOCATION:  
sec. 6 T 5 N R 4 E  
3 3/4 miles SE of Chula Vista  
(distance) (direction) (nearest town)

WELL PURPOSE: home  
(home, irrigation, municipal, industrial)

WELL COMPLETION DATA:  
(1) diameter (inches) 4  
(2) total depth (feet) 180  
(3) static water level (feet) 120 below above top of ground.  
(4) casing PVC 180 (material) (depth)  
(size) if telescope see back.  
(5) screen 7 ft 173 (length) (depth to top)  
4" gravel type (size) (material)  
(6) pump 1/2 10 (HP) (yield gpm)  
220V (type power)  
(7) electric log No (yes or no)  
(organization running log)  
(8) how well bottom plugged. Cup


DRILLERS REMARKS:

RECEIVED  
NOV - 7 1977

MISS. BD. OF WATER COMMISSIONERS

If well telescopes please sketch and show depths.

GROUND LEVEL

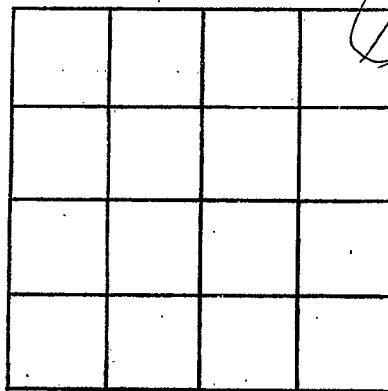

SECTION 6

Please indicate well location X.

ADDITIONAL INFORMATION

If more than one screen,  
show locations of each on sketch.