

Marshall  
R 2010  
12-9-77

MISSISSIPPI  
BOARD OF WATER COMMISSIONERS  
416 North State Street  
Jackson, Mississippi 39201

WATER WELL DRILLERS LOG

date well completed 12-9-77 firm name Hicks Well Co. county well located Marshall

LANDOWNER: Edo Alexander  
Rt. 5, Box 196  
Holly Springs, Mo  
(mailing address)

description of formations encountered	from	to
<del>Red sand</del>	0	115
Red sand		
White sand	115	170

WELL LOCATION:  
sec. 17 T. 5 N. R. 4 E.  
15 miles SE of Holly Springs, Mo  
(distance) (direction) (nearest town)

WELL PURPOSE: HOME  
(home, irrigation, municipal, industrial)

WELL COMPLETION DATA:

(1) diameter (inches) 4"

(2) total depth (feet) 170'

(3) static water level (feet) 90' below top of ground.

(4) casing PVC, 170'  
(material) (depth)  
(size) if telescope see back.

(5) screen 10ft, 160'  
(length) (depth to top)  
4", PVC-slotted  
(size) (material)

(6) pump 1/2 10  
(HP) (yield gpm)  
225V  
(type power)

(7) electric log No  
(yes or no)

(organization running log)

(8) how well bottom plugged Cap

DRILLERS REMARKS:


RECEIVED

DEC 19 1977

MISS. BD. OF WATER COMMISSIONERS

If well telescopes please sketch and show depths.

GROUND LEVEL

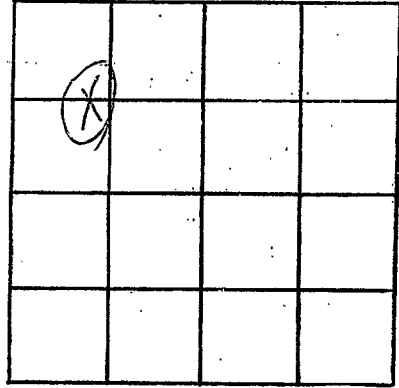

SECTION 17

Please indicate well location X.

ADDITIONAL INFORMATION

If more than one screen, show locations of each on sketch.