

Marshall
R 2011
12/12/77

MISSISSIPPI
BOARD OF WATER COMMISSIONERS
416 North State Street
Jackson, Mississippi 39201

WATER WELL DRILLERS LOG

12-12 1977 Hick Well Co. Marshall
date well completed firm name county well located

LANDOWNER Mt. Dillie Church
Rt. 5
Holly Springs, Ms.
(mailing address)

description of formations encountered	from	to
Red Clay	0	RT
Red Sand	15	200
White Sand + Clay	200	230
White Sand	230	267

WELL LOCATION:
sec. 13 T 5 N R 4 E
1 miles W of Salena
(distance) (direction) (nearest town)

WELL PURPOSE: Church
(home, irrigation, municipal, industrial)

WELL COMPLETION DATA:
(1) diameter (inches) 4
(2) total depth (feet) 267
(3) static water level (feet) 150 below above top of ground.
(4) casing PVC, 267,
(material) (depth)
(size) if telescope see back.
(5) screen 7ft, 260
(length) (depth to top)
4" gravel type
(size) (material)
(6) pump 3/4 10
(HP) (yield gpm)
220 V
(type power)
(7) electric log No
(yes or no)
(organization running log)
(8) how well bottom plugged Cap


DRILLERS REMARKS:

RECEIVED
DEC 19 1977

MISS. BD. OF WATER COMMISSIONERS

If well telescopes please sketch and show depths.

GROUND LEVEL

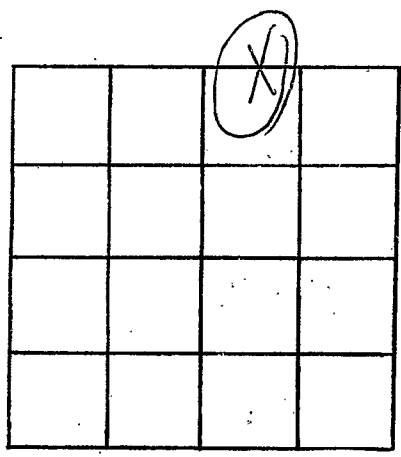

SECTION 13

Please indicate well location X.

ADDITIONAL INFORMATION

A series of horizontal lines for recording additional information.

If more than one screen, show locations of each on sketch.