

Marshall
R 2012
12/29/77

MISSISSIPPI
BOARD OF WATER COMMISSIONERS
416 North State Street
Jackson, Mississippi 39201

WATER WELL DRILLERS LOG

12-29-77 date well completed
Hicks Well Co. firm name
Marshall county well located

LANDOWNER: <u>Waverly T. Harris</u>	description of formations encountered	from	to
<u>Rt. 3, Holly Springs, Mo.</u> (mailing address)			
	Red clay	0	15
	Red sand	15	65
	white sand + clays	65	120
	white sand	120	153

WELL LOCATION:
sec. 17 T 5 N R 4 E
2 miles W of Chulahoma
(distance) (direction) (nearest town)

WELL PURPOSE: Home
(home, irrigation, municipal, industrial)

- WELL COMPLETION DATA:
- (1) diameter (inches) 4"
 - (2) total depth (feet) 153'
 - (3) static water level (feet) 115' below above top of ground.
 - (4) casing PVC, 153,
(material) (depth)
(size) if telescope see back.
 - (5) screen 7' 146'
(length) (depth to top)
4" gravel type
(size) (material)
 - (6) pump 1/2 107
(HP) (yield gpm)
220V
(type power)
 - (7) electric log No
(yes or no)

(organization running log)
(8) how well bottom plugged Cap


DRILLERS REMARKS:

RECEIVED
JAN 13 1978

MISS. BD. OF WATER COMMISSIONERS

If well telescopes please sketch and show depths.

GROUND LEVEL

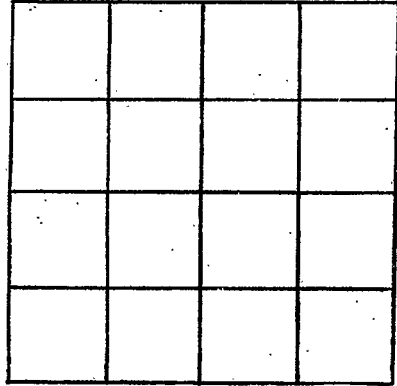

SECTION _____

Please indicate well location X.

ADDITIONAL INFORMATION

If more than one screen, show locations of each on sketch.