

MARSHALL

R 2013

6-9-78

MISSISSIPPI BOARD OF WATER COMMISSIONERS
416 North State Street
Jackson, Mississippi 39201

WATER WELL DRILLERS LOG

MARSHALL

6-9-78
date well completed

1978 High Well Co
firm name

Fate
county well located

LANDOWNER:

Mrs. Jesse May

description of formations encountered

from to

Rt. 5

Red Clay

0 30

Holly Springs, Ms.
(mailing address)

White Clay + Sand

30 160

WELL LOCATION:

sec. 30 T 5 N R 4 E
2 1/2 miles SE of Wattle
(distance) (direction) (nearest town)

White Sand

160 220

WELL PURPOSE:

Home
(home, irrigation, municipal, industrial)

WELL COMPLETION DATA:

- (1) diameter (inches) 4
- (2) total depth (feet) 220
- (3) static water level (feet) 188 below top of ground
- (4) casing PVC 220
(material) (depth)

If telescope see back.
(size)

- (5) screen 7 213
(length) (depth to top)

4' gravel type
(size) (material)

- (6) pump 34 10
(HP) (yield gpm)

220V
(type power)

- (7) electric log No
(yes or no)

(organization running log)

- (8) how well bottom plugged Cap


DRILLERS REMARKS:

RECEIVED

JUN 20 1978

If well telescopes please sketch and show depths.

GROUND LEVEL

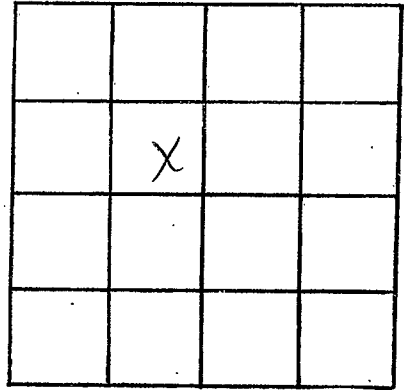

SECTION 30

Please indicate well location X.

ADDITIONAL INFORMATION

If more than one screen,
show locations of each on sketch.