

MARSHALL
R 2014
9-18-78

**MISSISSIPPI
BOARD OF WATER COMMISSIONERS**
416 North State Street
Jackson, Mississippi 39201
WATER WELL DRILLERS LOG

9-18 date well completed 1978 Hicks well co firm name Marshall county well located


LANDOWNER: Charles Godsey	description of formations encountered	from	to
RT. 3 HOLLY SPRINGS, MISS (mailing address)			
WELL LOCATION: sec. 8 T 14 S N R 4 E 1 1/2 mi. 077 # 40 N 309 (distance) (direction) (nearest town)	Red c	0	10
	WC & SAND	10	140
	W. SAND	140	167
WELL PURPOSE: Home (home, irrigation, municipal, industrial)			
WELL COMPLETION DATA: (1) diameter (inches) 4" (2) total depth (feet) 167 (3) static water level (feet) 120 below top of ground. (4) casing PVC, 167' (material) (depth) (size) If telescope see back. (5) screen 7' 7' (length) (depth to top) 4" 02, INSIDE ROCK (size) (material) (6) pump 1/2 10 (HP) (yield gpm) 220 ELEC (type power) (7) electric log NO (yes or no) (organization running log) (8) how well bottom plugged CAP			
DRILLERS REMARKS:			

RECEIVED
SEP 25 1978

MISS. BD. OF WATER COMMISSIONERS

If well telescopes please sketch and show depths.

GROUND LEVEL

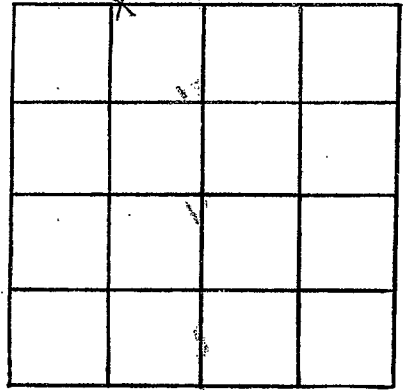

SECTION _____

Please indicate well location X.

ADDITIONAL INFORMATION

If more than one screen,
show locations of each on sketch.