

MARSHALL

R 2015

8-28-78

MISSISSIPPI BOARD OF WATER COMMISSIONERS
416 North State Street
Jackson, Mississippi 39201

WATER WELL DRILLERS LOG

8-28

date well completed

1978 Hicks well CO

firm name

MARSHALL

county well located

LANDOWNER: MACK TOTTEN

RT. 3 Holly Springs,

MISS
(mailing address)

description of formations encountered

from to

Red CLAY	0	15
Red CLAY & SAND	15	60
Red SAND	60	130
White SAND	130	180

WELL LOCATION:

sec. 6 T. N R. 5
3 miles N of INTX #444
(distance) (direction) (nearest town)

WELL PURPOSE: Home
(home, irrigation, municipal, industrial)

WELL COMPLETION DATA:

- (1) diameter (inches) 4"
- (2) total depth (feet) 180
- (3) static water level (feet) 130 below top of ground.
- (4) casing PVC 180
(material) (depth)

 if telescope see back.
(size)

- (5) screen 7' 7'
(length) (depth to top)

4" Inside Rock 02
(size) (material)

- (6) pump 1/2 10
(HP) (yield gpm)


220 P.100
(type power)

- (7) electric log
(yes or no)

(organization running log)

- (8) how well bottom plugged CAP


DRILLERS REMARKS:

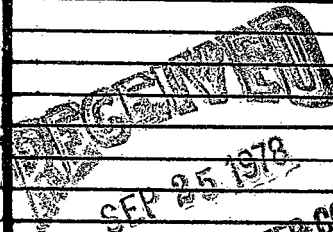

MISS. BD. OF WATER COM.

If well telescopes please sketch and show depths.

GROUND LEVEL

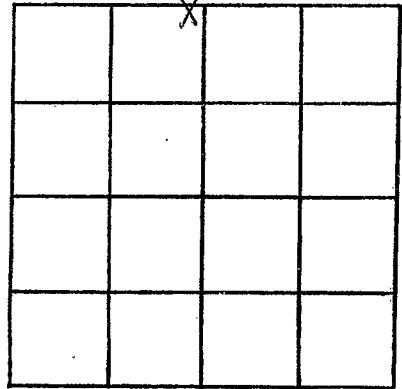

SECTION _____

Please indicate well location X.

ADDITIONAL INFORMATION

If more than one screen,
show locations of each on sketch.