

MARSHALL

R 2016

7-28-78

MISSISSIPPI BOARD OF WATER COMMISSIONERS
416 North State Street
Jackson, Mississippi 39201

WATER WELL DRILLERS LOG

7-28 1978 Hickshell Co Marshall
date well completed firm name county well located

LANDOWNER: Charlie Sanders

Description of formations encountered from to

Rt. 5

Holly Springs Ms
(mailing address)

Red Clay	0	20
Red Clay + Sand	20	40
Red Sand	40	180
Chulahoma White Sand	180	230

WELL LOCATION:

sec. 11 T. 5 N. R. 4 E. S. 1 W. 2 miles E of Chulahoma
(distance) (direction) (nearest town)

WELL PURPOSE: Home
(home, irrigation, municipal, industrial)

WELL COMPLETION DATA:

- (1) diameter (inches) 4
- (2) total depth (feet) 230
- (3) static water level (feet) 160 below top of ground.
- (4) casing PVC, 230 (material) (depth)
- (size) if telescope see back.
- (5) screen 7' (length) 223 (depth to top)
- 4" gravel type (size) (material)
- (6) pump 3/4 (HP) 10 (yield gpm)
- 228 V (type power)
- (7) electric log No (yes or no)

(organization running log)


(8) how well bottom plugged Cap

DRILLERS REMARKS:

RECEIVED
SEP 25 1978
MISS. BD. OF WATER COMMISSIONERS

If well telescopes please sketch and show depths.

GROUND LEVEL

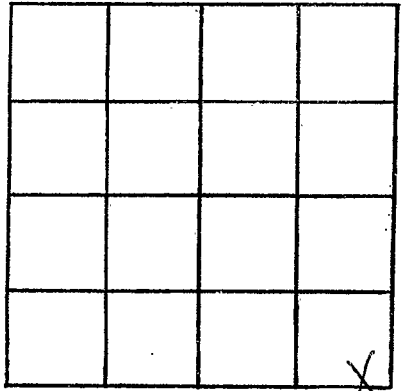

SECTION 11

Please indicate well location X.

ADDITIONAL INFORMATION

If more than one screen, show locations of each on sketch.