

MARSHALL

R 2017

12/12/78

Dec 12

MISSISSIPPI
 BOARD OF WATER COMMISSIONERS
 416 North State Street
 Jackson, Mississippi 39201

WATER WELL DRILLERS LOG

date well completed

firm name

county well located

19 78 R. L. Carpenter Marshall

LANDOWNER: Woodson Odell

Chulahoma, Miss

RFD

(mailing address)

description of formations encountered

from

to

Surface Soil

0

18

med white sand

18

40

white clay & fine sand mixed

40

82

med white sand

82

110

white coarse sand

110

168

WELL LOCATION:

sec. 29 T. 5 N R. 4 E
 S W
2 1/2 miles South of Chulahoma
 (distance) (direction) (nearest town)

WELL PURPOSE: None
 (home, irrigation, municipal, industrial)

WELL COMPLETION DATA:

(1) diameter (inches) 4

(2) total depth (feet) 148

(3) static water level (feet) 123 below above top of ground.

(4) casing Plastic, 138'
(material) (depth)

(size) If telescope see back.

(5) screen 10', 138'
(length) (depth to top)

4", Plastic
(size) (material)

(6) pump 3/4, 12
(HP) (yield gpm)

Elec
(type power)

(7) electric log no
(yes or no)

(organization running log)

(8) how well bottom plugged PVC cap

DRILLERS REMARKS:


DEPT. OF NATURAL RESOURCES
 BUREAU OF LAND & WATER RESOURCES

MAY 18 1981

RECEIVED

If well telescopes please sketch and show depths.

GROUND LEVEL

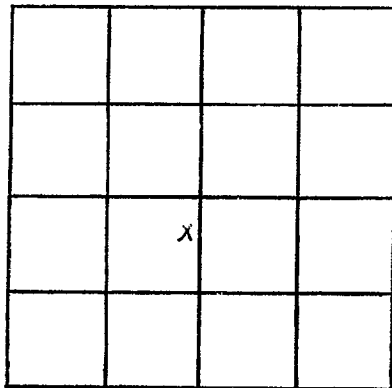

SECTION 29

Please indicate well location X.

ADDITIONAL INFORMATION

If more than one screen,
show locations of each on sketch.