

MARSHALL
 R 2018
 12-15-78

MISSISSIPPI
 BOARD OF WATER COMMISSIONERS
 416 North State Street
 Jackson, Mississippi 39201

WATER WELL DRILLERS LOG

12-15 1978 Hicks Well Co Marshall
 date well completed firm name county well located


LANDOWNER: John Heister
Holly Springs, Mo. 38635
 (mailing address)
 WELL LOCATION:
 sec. 21 T 5 N R 4 E
5 miles SW of Jacks Hill
 (distance) (direction) (nearest town)

description of formations encountered	from	to
<u>Red Clay</u>	<u>0</u>	<u>10</u>
<u>Red sand</u>	<u>10</u>	<u>50</u>
<u>White Clay</u>	<u>50</u>	<u>120</u>
<u>White sand</u>	<u>120</u>	<u>230</u>

WELL PURPOSE: Home
 (home, irrigation, municipal, industrial)

WELL COMPLETION DATA:
 (1) diameter (inches) 4"
 (2) total depth (feet) 230
 (3) static water level (feet) 160 below top of ground.
 (4) casing PVC, 230,
 (material) (depth)
 (size) if telescope see back.
 (5) screen 7, ~~223~~
 (length) (depth to top)
4", gravel top
 (size) (material)
 (6) pump 3/4, 10
 (HP) (yield gpm)
220V
 (type power)
 (7) electric log No
 (yes or no)
 (organization running log)
 (8) how well bottom plugged Cap


DRILLERS REMARKS:

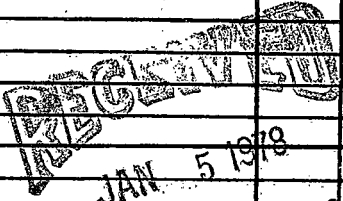

MISS. BD. OF WATER COMM

If well telescopes please sketch and show depths.

GROUND LEVEL

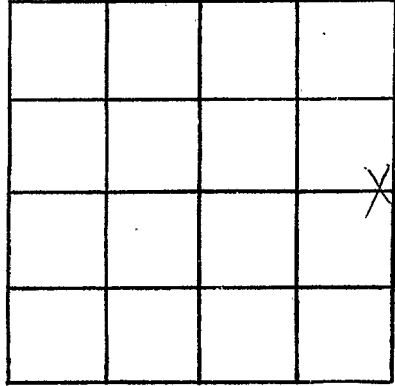

SECTION 21

Please indicate well location X.

ADDITIONAL INFORMATION

If more than one screen, show locations of each on sketch.