

MARSHALL
 R 2049
 4-25-79

MISSISSIPPI
 BOARD OF WATER COMMISSIONERS
 416 North State Street
 Jackson, Mississippi 39201

WATER WELL DRILLERS LOG

date well completed 4/25 19 79 Rich's Well Co firm name Marshall county well located

LANDOWNER: John Algee
 (mailing address)
 WELL LOCATION:
 sec. 9 T. 4 N. R. 5 E.
1 miles (distance) of Chulahoma (direction) (nearest town)

description of formations encountered	from	to
<u>Red Clay</u>	<u>0</u>	<u>20</u>
<u>Red Clay + Red Sand</u>	<u>20</u>	<u>65</u>
<u>Red Sand</u>	<u>65</u>	<u>120</u>
<u>Chulahoma White Sand</u>	<u>120</u>	<u>180</u>

WELL PURPOSE: home
 (home, irrigation, municipal, industrial)

WELL COMPLETION DATA:
 (1) diameter (inches) 4 in
 (2) total depth (feet) 180 ft
 (3) static water level (feet) 115 below above top of ground
 (4) casing Plastic 180 (material) (depth)
 (size) if telescope see back.
 (5) screen 7 ft 173 ft (length) (depth to top)
4 in Gravel (size) (material)
 (6) pump 10 1/2 10 (HP) (yield gpm)
220 (type power)
 (7) electric log No (yes or no)
 (organization running log)
 (8) how well bottom plugged Cop

DRILLERS REMARKS:


Miss. Board of Water Comm.

MAY 15 1979

RECEIVED

If well telescopes please sketch and show depths.

GROUND LEVEL

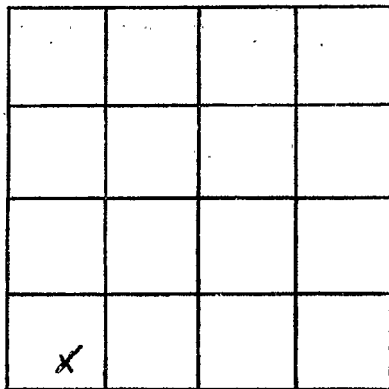

SECTION 9

Please indicate well location X.

ADDITIONAL INFORMATION

If more than one screen, show locations of each on sketch.