

MARSHALL
R. 2000
4-30-79

MISSISSIPPI
BOARD OF WATER COMMISSIONERS
 416 North State Street
 Jackson, Mississippi 39201

WATER WELL DRILLERS LOG

date well completed 4-30-79 firm name Jack's Well Co. county well located Marshall

LANDOWNER:	description of formations encountered	from	to
<u>TV4 King</u> <u>Rt. 3, Holly Springs, Miss</u> (mailing address)			
WELL LOCATION: sec. <u>17</u> T. <u>4</u> S. R. <u>4</u> E <u>1</u> miles <u>West</u> of <u>Chulahoma</u> (distance) (direction) (nearest town)	<u>Red Clay & Red Sand</u>	<u>20</u>	<u>60</u>
	<u>Red Sand</u>	<u>60</u>	<u>100</u>
	<u>White Sand</u>	<u>100</u>	<u>155</u>

WELL PURPOSE: home
 (home, irrigation, municipal, industrial)


- WELL COMPLETION DATA:**
- (1) diameter (inches) 4 in
 - (2) total depth (feet) 155
 - (3) static water level (feet) 90 below top of ground.
 - (4) casing Plastic, 155
 (material) (depth)
 - (size) if telescope see back.
 - (5) screen 7ft, 148ft
 (length) (depth to top)
 - 4 in, Gravel
 (size) (material)
 - (6) pump 1/2, 10
 (HP) (yield gpm)
 - 220
 (type power)
 - (7) electric log No
 (yes or no)
 - (organization running log)
 - (8) how well bottom plugged Cap

DRILLERS REMARKS:

Miss. Board of Water Comm.
 MAY 15 1979
RECEIVED

If well telescopes please sketch and show depths.

GROUND LEVEL

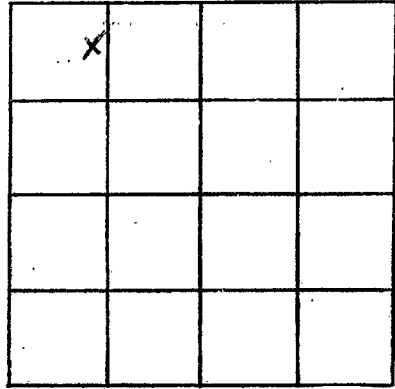

SECTION 17

Please indicate well location X.

ADDITIONAL INFORMATION

If more than one screen, show locations of each on sketch.