

Marshall
R 2023
5-13-80

MISSISSIPPI
BOARD OF WATER COMMISSIONERS
416 North State Street
Jackson, Mississippi 39201

WATER WELL DRILLERS LOG

5.2 1980 Rich's Well Co Marshall
date well completed firm name county well located

LANDOWNER:
Williams, Madland
Rt. 5, Holly Springs
(mailing address)

description of formations encountered	from	to
	clay	0
red sand	20	170

WELL LOCATION:
sec. 30 T-5 N R-4 E
Candy line RD.
miles of (distance) (direction) (nearest town)

white sand	170	245
------------	-----	-----

WELL PURPOSE: home
(home, irrigation, municipal, industrial)

WELL COMPLETION DATA:

(1) diameter (inches) 4 in

(2) total depth (feet) 245

(3) static water level (feet) 190 below above top of ground.

(4) casing Plastic 245
(material) (depth)

(size) if telescope see back.

(5) screen 7 ft 238
(length) (depth to top)

4 in Galvanized
(size) (material)

(6) pump 3/4 10
(HP) (yield gpm)

220
(type power)

(7) electric log No
(yes or no)

(organization running log)

(8) how well bottom plugged Cap

DEPT. OF NATURAL RESOURCES
BUREAU OF LAND & WATER RESOURCES


MAY 12 1980

RECEIVED

DRILLERS REMARKS:

If well telescopes please sketch and show depths.

GROUND LEVEL

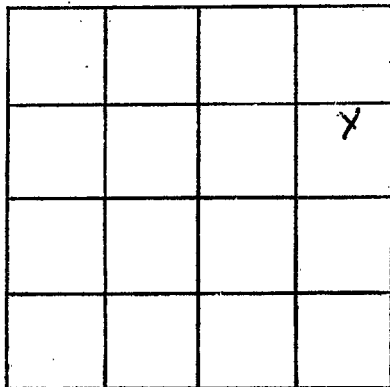

SECTION 30

Please indicate well location X.

ADDITIONAL INFORMATION

If more than one screen,
show locations of each on sketch.