

MISSISSIPPI DEPARTMENT OF NATURAL RESOURCES

Bureau of Land and Water Resources

Southport Mall

P.O. Box 10631

Jackson, Mississippi 39209

WATER WELL DRILLERS LOG

MARSHALL
R 2026
5-5-81

5-5 19 81 Hicks Well Co. Marshall
date well completed firm name county well located


LANDOWNER: Ueda Stewart
Rt. 5
Holly Springs, MS
(mailing address)

description of formations encountered	from	to
<u>Red sand</u>	<u>0</u>	<u>30</u>
<u>White sand</u>	<u>30</u>	<u>155</u>

WELL LOCATION:
sec. 16 T. 5 N. R. 4 E.
8 4
_____ miles _____ of Chula Vista
(distance) (direction) (nearest town)

WELL PURPOSE: stone
(home, irrigation, municipal, industrial)


- WELL COMPLETION DATA:
- (1) diameter (inches) 4
 - (2) total depth (feet) 155
 - (3) static water level (feet) 100 below above top of ground.
 - (4) casing PVC 155
(material) (depth)
 - _____ if telescope see back.
(size)
 - (5) screen 10 145
(length) (depth to top)
 - 4" slotted PVC
(size) (material)
 - (6) pump 1/2 10
(HP) (yield gpm)
 - 220V
(type power)
 - (7) electric log No
(yes or no)
 - _____ (organization running log)
 - (8) how well bottom plugged Cap

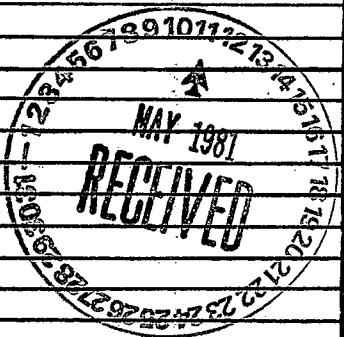

DRILLERS REMARKS: _____

If well telescopes please
sketch and show depths.

GROUND LEVEL

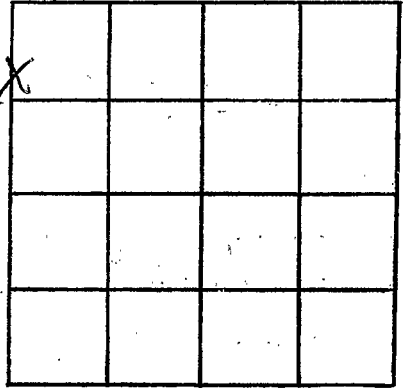

SECTION 16

Please indicate well location X.

ADDITIONAL INFORMATION

If more than one screen,
show locations of each on sketch.