

MISSISSIPPI DEPARTMENT OF NATURAL RESOURCES

Bureau of Land and Water Resources

Southport Mall

P.O. Box 10631

Jackson, Mississippi 39209

WATER WELL DRILLERS LOG

Marshall  
R 2027  
9-28-81

Marshall  
 county well located

9-28 1981 **HICKS WELL COMPANY**  
 date well completed RT. 1 - BOX #157 name:

LANDOWNER: William Cot  
2592 McArthur  
Memphis, Tenn. 38126  
 (mailing address)

description of formations encountered	from	to
<u>Red Clay</u>	<u>0</u>	<u>10</u>
<u>Red sand</u>	<u>10</u>	<u>65</u>
<u>White sand</u>	<u>65</u>	<u>265</u>

WELL LOCATION:  
 sec. 28 T. 5 N. R. 4 E.  
3 miles S of Shulbourn  
 (distance) (direction) (nearest town)

WELL PURPOSE: Farm  
 (home, irrigation, municipal, industrial)

WELL COMPLETION DATA:

(1) diameter (inches) 4  
 (2) total depth (feet) 196  
 (3) static water level (feet) 180 below above top of ground.  
 (4) casing PVC, 196,  
 (material) (depth)  
 (size) If telescope see back.  
 (5) screen 12, 184  
 (length) (depth to top)  
4", Gravel PVC  
 (size) (material)  
 (6) pump 3/4, 10  
 (HP) (yield gpm)  
220V  
 (type power)  
 (7) electric log No  
 (yes or no)

(organization running log)  
 (8) how well bottom plugged Cap

DRILLERS REMARKS:


DEPT. OF NATURAL RESOURCES  
 BUREAU OF LAND & WATER RESOURCES

OCT 10 1981

RECEIVED

If well telescopes please sketch and show depths.

GROUND LEVEL

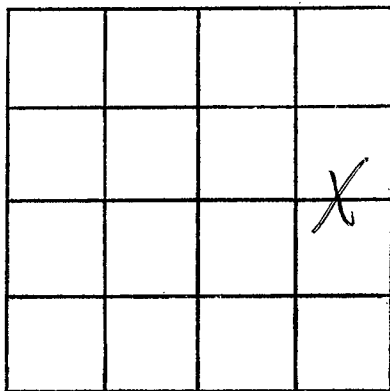

SECTION 28

Please indicate well location X.

ADDITIONAL INFORMATION

If more than one screen, show locations of each on sketch.