

MISSISSIPPI DEPARTMENT OF NATURAL RESOURCES

Bureau of Land and Water Resources

Southport Mall

P.O. Box 10631

Jackson, Mississippi 39209

WATER WELL DRILLERS LOG

**MARSHALL**  
**R 2028**  
**10-29-81**

10-29 1981  
 date well completed

HICKS WELL COMPANY

RI. I - BIRMINGHAM

Marshall  
 county well located

LANDOWNER: Chad Faulkner  
Rd. 3 Box 96  
Holly Springs, Mo.  
 (mailing address)

MISS. description of formations encountered	from	to
Red Clay	0	10
Red Sand	10	20
White Clay + Sand	20	90
White Sand	90	164

WELL LOCATION:  
 sec. 7 T 5 N R 4 E  
3 miles NW of Chulahoma  
 (distance) (direction) (nearest town)

WELL PURPOSE: Home  
 (home, irrigation, municipal, industrial)

WELL COMPLETION DATA:

- (1) diameter (inches) 4
- (2) total depth (feet) 164
- (3) static water level (feet) 100 below above top of ground.
- (4) casing PVC 164  
 (material) (depth)
- if telescope see back.  
 (size)
- (5) screen 7 157  
 (length) (depth to top)  
4 gravel + PVC  
 (size) (material)
- (6) pump 1/2 10  
 (HP) (yield gpm)  
220V  
 (type power)
- (7) electric log No  
 (yes or no)
- (organization running log)

(8) how well bottom plugged Cap

DRILLERS REMARKS:


DEPT. OF NATURAL RESOURCES  
 BUREAU OF LAND & WATER RESOURCES

NOV 9 - 1981

RECEIVED

If well telescopes please sketch and show depths.

GROUND LEVEL

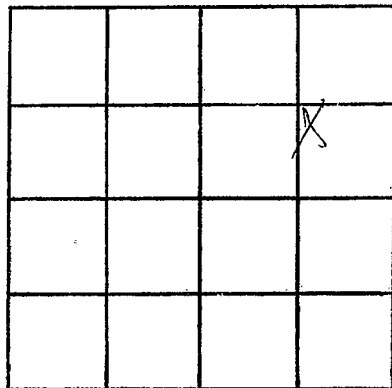

SECTION 7

Please indicate well location X.

ADDITIONAL INFORMATION

If more than one screen, show locations of each on sketch.