

Marshall
R
2030

MISSISSIPPI DEPARTMENT OF NATURAL RESOURCES
Bureau of Land and Water Resources
 Southport Mall
 P.O. Box 10631

Jackson, Mississippi 39209

WATER WELL DRILLERS LOG

HICKS WELL CO.
 Rt. 1, Box 157

Senatobia, MS 38668

date well completed 2-18-83

county well located Marshall

LANDOWNER: Scarsine Walker
Rt. 3 Box 79

description of formations encountered	from	to
<u>Red Sand</u>	<u>0</u>	<u>60</u>
<u>White Sand</u>	<u>60</u>	<u>185</u>

Holly Springs, Miss 38635
 (mailing address)

WELL LOCATION:

sec. 3 T 5 N R 4 E
3 miles NE of Chula Vista
 (distance) (direction) (nearest town)

WELL PURPOSE:

(home, irrigation, municipal, industrial) Home

WELL COMPLETION DATA:

- (1) diameter (inches) 4
- (2) total depth (feet) 185
- (3) static water level (feet) 80 below above top of ground.
- (4) casing PVC, 185,
 (material) (depth)
- 4"
 (size) If telescope see back.
- (5) screen 10, 175
 (length) (depth to top)
- 2 1/2", PVC
 (size) (material)
- (6) pump 1/2, 10
 (HP) (yield gpm)
- 220V
 (type power)
- (7) electric log No
 (yes or no)

(organization running log)

(8) how well bottom plugged Cap

DRILLERS REMARKS:


DEPT. OF NATURAL RESOURCES
 BUREAU OF LAND & WATER RESOURCES

MAR 28 1983

RECEIVED

If well telescopes please
sketch and show depths.

GROUND LEVEL

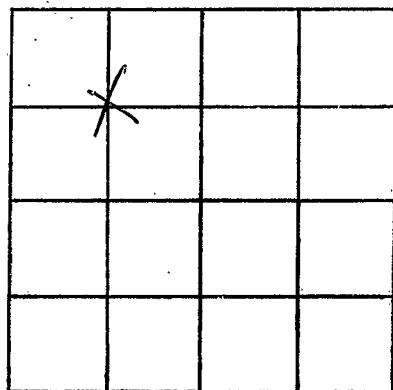

SECTION 3

Please indicate well location X.

ADDITIONAL INFORMATION

If more than one screen,
show locations of each on sketch.