

MISSISSIPPI DEPARTMENT OF NATURAL RESOURCES

Bureau of Land and Water Resources

Southport Mall

P.O. Box 10631

Jackson, Mississippi 39209

WATER WELL DRILLERS LOG

Marshall
R
2032

9-29 1983
date well completed

HICKS WELL CO.

RE 1, LHM hnd
Spartanburg, MS 38669

Marshall
county well located

LANDOWNER: Bud & Dullery

description of formations encountered

from

to

Rt. 3

Holly Springs, Ms.
(mailing address) 38635

Red Clay

0 10

Red Sand

10 40

WELL LOCATION:

sec. S T 5 N R 4 E
2 miles NW of Chalabona
(distance) (direction) (nearest town)

White Sand

40 185

WELL PURPOSE: Home
(home, irrigation, municipal, industrial)

WELL COMPLETION DATA:

- (1) diameter (inches) 4
- (2) total depth (feet) 185
- (3) static water level (feet) 100 ^{below} _{above} top of ground.
- (4) casing PVC, 185,
(material) (depth)
4"
(size) if telescope see back.
- (5) screen 10', 175'
(length) (depth to top)
1013, PVC
(size) (material)
- (6) pump 1/2 10
(HP) (yield gpm)
220V
(type power)
- (7) electric log No
(yes or no)

(organization running log)

(8) how well bottom plugged Cap


DRILLERS REMARKS:

DEPT. OF NATURAL RESOURCES
BUREAU OF LAND & WATER RESOURCES

OCT 13 1983
RECEIVED

If well telescopes please sketch and show depths.

GROUND LEVEL

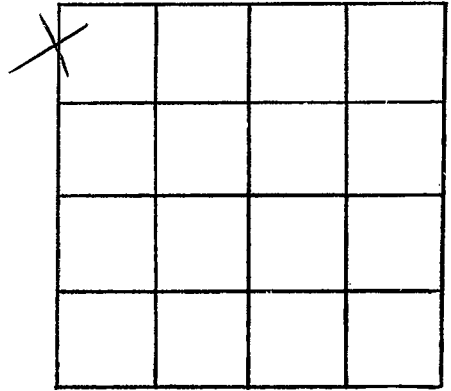

SECTION 5

Please indicate well location X.

ADDITIONAL INFORMATION

If more than one screen,
show locations of each on sketch.