

MISSISSIPPI DEPARTMENT OF NATURAL RESOURCES

Bureau of Land and Water Resources

Southport Mall

P.O. Box 10631

Jackson, Mississippi 39209

WATER WELL DRILLERS LOG

HICKS WELL CO.

Rt. 1 Box 157

Senatobia, MS 38668

county well located

*Marshall*  
R  
2033

1/6 1984  
date well completed

*Marshall*

LANDOWNER: *Phillip Milam*  
*Rt. 3 Box 94K*  
*Holly Springs, Mo. 38635*  
(mailing address)

| description of formations encountered | from       | to         |
|---------------------------------------|------------|------------|
| <i>Red clay</i>                       | <i>0</i>   | <i>20</i>  |
| <i>Red sand</i>                       | <i>20</i>  | <i>50</i>  |
| <i>White clay + sand</i>              | <i>50</i>  | <i>100</i> |
|                                       | <i>100</i> | <i>135</i> |

WELL LOCATION:  
sec. 17 T. 5 N. R. 4 E.  
1 miles W of Senatobia  
(distance) (direction) (nearest town)

WELL PURPOSE: *Home*  
(home, irrigation, municipal, industrial)

- WELL COMPLETION DATA:
- (1) diameter (inches) 4
  - (2) total depth (feet) 135
  - (3) static water level (feet) 100 <sup>below</sup>/<sub>above</sub> top of ground.
  - (4) casing PVC, 135,  
(material) (depth)  
4"  
(size) If telescope see back.
  - (5) screen 10, 125  
(length) (depth to top)  
1010, PVC  
(size) (material)
  - (6) pump 1/2 10  
(HP) (yield gpm)  
2200  
(type power)
  - (7) electric log No  
(yes or no)  
No  
(organization running log)
  - (8) how well bottom plugged Caps

DRILLERS REMARKS:


DEPT. OF NATURAL RESOURCES  
BUREAU OF LAND & WATER RESOURCES

JAN 30 1984

RECEIVED

If well telescopes please sketch and show depths.

GROUND LEVEL

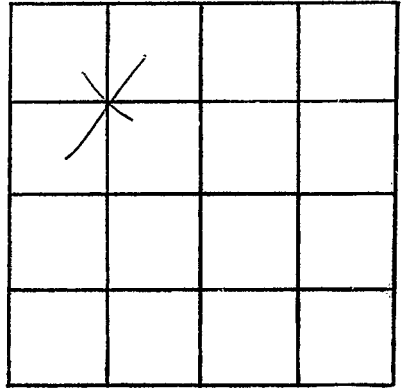

SECTION 17

Please indicate well location X.

ADDITIONAL INFORMATION

If more than one screen,  
show locations of each on sketch.