

MISSISSIPPI DEPARTMENT OF NATURAL RESOURCES

Bureau of Land and Water Resources

Southport Mall

P.O. Box 10631

Jackson, Mississippi 39209

WATER WELL DRILLERS LOG

Marshall  
R  
2034

2/9 1984  
 date well completed

WICKS WELL CO.  
 firm Box 157  
 location, no. 00000

Marshall  
 county well located

LANDOWNER: Dewey Green

description of formations encountered	from	to

Rt. 5

Holly Springs, Mo. 31135  
 (mailing address)

<u>Red Clay</u>	<u>0</u>	<u>15</u>
-----------------	----------	-----------

WELL LOCATION:

<u>Red Sand</u>	<u>15</u>	<u>40</u>
-----------------	-----------	-----------

sec. 30 T 5 N (S) R 4 E (W)

<u>White Sand</u>	<u>40</u>	<u>215</u>
-------------------	-----------	------------

2 miles S of Wynette  
 (distance) (direction) (nearest town)

WELL PURPOSE: Home  
 (home, irrigation, municipal, industrial)

WELL COMPLETION DATA:

(1) diameter (inches) 4

(2) total depth (feet) 215

(3) static water level (feet) 180 <sup>below</sup> top of ground.

(4) casing PVC, 215,  
 (material) (depth)

1/2"  
 (size) if telescope see back.

(5) screen 10', 2.05'  
 (length) (depth to top)

1013, PVC  
 (size) (material)

(6) pump 3/4 10  
 (HP) (yield gpm)

2201  
 (type power)

(7) electric log No  
 (yes or no)

(organization running log)

(8) how well bottom plugged Cap

DRILLERS REMARKS:


DEPT. OF NATURAL RESOURCES  
 BUREAU OF LAND & WATER RESOURCES

MAR 19 1984

RECEIVED

If well telescopes please sketch and show depths.

GROUND LEVEL

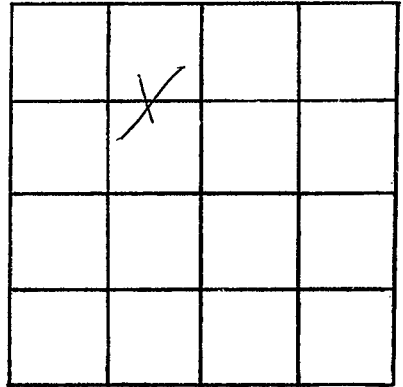

SECTION 30

Please indicate well location X.

ADDITIONAL INFORMATION

If more than one screen,  
show locations of each on sketch.