

MISSISSIPPI DEPARTMENT OF NATURAL RESOURCES

Bureau of Land and Water Resources

Southport Mall

P.O. Box 10631

Jackson, Mississippi 39209

WATER WELL DRILLERS LOG

Marshall
R 2035

HICKS WELL CO.

Marshall

4/6 1984
date well completed

film handle BOX 157
Senatobia MS 38668

county well located

LANDOWNER: *Milton Bell*

description of formations encountered

from

to

Rt. 3

Holly Springs Ms. 38630
(mailing address)

Red Clay

0

18

WELL LOCATION:

sec. 20 T S N R 4 E

Red Clay & Sand

10

50

1 miles S of Chulahoma
(distance) (direction) (nearest town)

Red Sand

50

70

White Sand

70

170

WELL PURPOSE: *Home*
(home, irrigation, municipal, industrial)

WELL COMPLETION DATA:

(1) diameter (inches) 4

(2) total depth (feet) 170

(3) static water level (feet) 120 ^{below} above top of ground.

(4) casing PVC, 170
(material) (depth)

4"
(size) If telescope see back.

(5) screen 10', 160'
(length) (depth to top)

200, PVC
(size) (material)

(6) pump 3/4, 10
(HP) (yield gpm)

220V
(type power)

(7) electric log No
(yes or no)

(organization running log)

(8) how well bottom plugged Cap

DRILLERS REMARKS:


DEPT. OF NATURAL RESOURCES
BUREAU OF LAND & WATER RESOURCES

APR 16 1984

RECEIVED

If well telescopes please sketch and show depths.

GROUND LEVEL

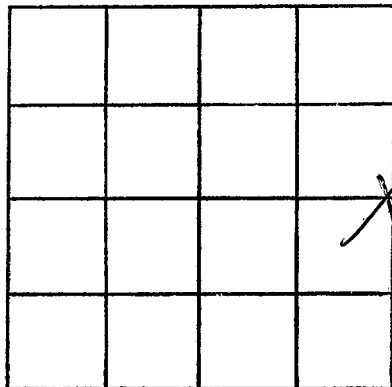

SECTION 20

Please indicate well location X.

ADDITIONAL INFORMATION

If more than one screen,
show locations of each on sketch.