

MISSISSIPPI DEPARTMENT OF NATURAL RESOURCES

Bureau of Land and Water Resources

Southport Mall

P.O. Box 10631

Jackson, Mississippi 39209

WATER WELL DRILLERS LOG

MARSHALL
R
2036

6/5 1984
date well completed

HICKS WELL CO.
firm name 157

Marshall
county well located

LANDOWNER: Essix Steward
P.O. Box 196A
Holly Springs, MS 38635
(mailing address)

description of formations encountered	from	to
Red Clay	0	10
Red Sand	10	60

WELL LOCATION:
sec. 9 T. 5 N. R. 4 E.
1/2 miles N of Chulahoma
(distance) (direction) (nearest town)

White Sand + Clay	60	158
White Sand	158	215

WELL PURPOSE: Home
(home, irrigation, municipal, industrial)


- WELL COMPLETION DATA:
- (1) diameter (inches) 4
 - (2) total depth (feet) 215
 - (3) static water level (feet) 190 ^{below} above top of ground.
 - (4) casing PVC, 215,
(material) (depth)
4 if telescope see back.
(size)
 - (5) screen 10, 205
(length) (depth to top)
1010, PVC
(size) (material)
 - (6) pump 3/4, 10
(HP) (yield gpm)
220V
(type power)
 - (7) electric log No
(yes or no)
(organization running log)
 - (8) how well bottom plugged Cap

DRILLERS REMARKS:

DEPT. OF NATURAL RESOURCES
BUREAU OF LAND & WATER RESOURCES
JUL 10 1984
RECEIVED

If well telescopes please sketch and show depths.

GROUND LEVEL

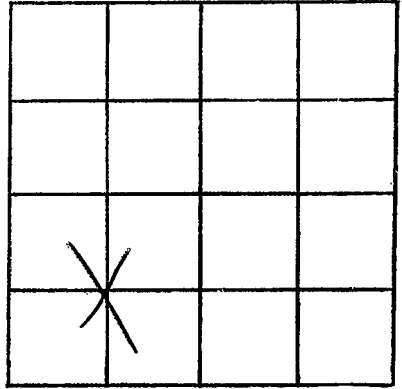

SECTION 9

Please indicate well location X.

ADDITIONAL INFORMATION

Lined area for additional information.

If more than one screen, show locations of each on sketch.