

Marshall
R
2037

MISSISSIPPI DEPARTMENT OF NATURAL RESOURCES

Bureau of Land and Water Resources

Southport Mall

P.O. Box 10631

Jackson, Mississippi 39209

WATER WELL DRILLERS LOG

HICKS WELL CO.
P.O. Box 157
Senatobia, MS 38668

Marshall
county well located

9-24 19 84
date well completed

LANDOWNER: Shelton Stewart
Pt. 3

Holly Springs, Ms.
(mailing address) 37635
description of formations encountered from to
Red Sand 0 50
White sand 50 110

WELL LOCATION:
sec. 16 T 5 N R 4 E
S W
_____ miles _____ of Charlottesville
(distance) (direction) (nearest town)
description of formations encountered from to
White sand & clay 110 140
White Sand 140 160

WELL PURPOSE: Home
(home, irrigation, municipal, industrial)

- WELL COMPLETION DATA:
- (1) diameter (inches) 4
 - (2) total depth (feet) 160
 - (3) static water level (feet) 100 ^{below} above top of ground.
 - (4) casing PVC, 160,
(material) (depth)
4"
(size) if telescope see back.
 - (5) screen 10', 150'
(length) (depth to top)
.010, PVC
(size) (material)
 - (6) pump 1/2, 18
(HP) (yield gpm)
220V
(type power)
 - (7) electric log No
(yes or no)
 - (organization running log)
 - (8) how well bottom plugged Cap

DRILLERS REMARKS:


DEPT OF NATURAL RESOURCES
BUREAU OF LAND & WATER RESOURCES

NOV 28 1984

RECEIVED

If well telescopes please sketch and show depths.

GROUND LEVEL

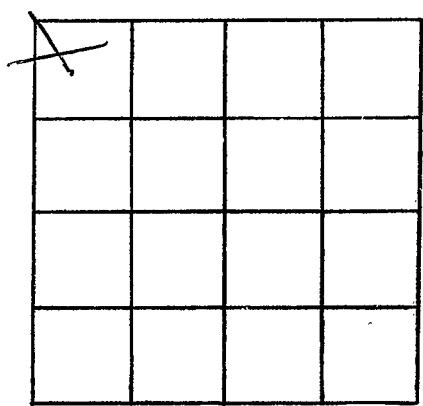

SECTION 16

Please indicate well location X.

ADDITIONAL INFORMATION

A series of horizontal lines for writing additional information.

If more than one screen, show locations of each on sketch.