

MISSISSIPPI DEPARTMENT OF NATURAL RESOURCES

Bureau of Land and Water Resources

Southport Mall

P.O. Box 10631

Jackson, Mississippi 39209

WATER WELL DRILLERS LOG

HICKS WELL COMPANY

Marshall
R 2039
4-16-85

4-16 19 85
 date well completed

RT. 1 BOX 157
 firm name
 SENATORIA, MISS.

Marshall
 county well located

LANDOWNER: Hal Waldrip

R # 3

Hally Springs 38835
 (mailing address)

WELL LOCATION:

sec. 16 T. 5 N. R. 4 E.
 (S) (W)
— miles of Chulahoma
 (distance) (direction) (nearest town)

WELL PURPOSE: Home
 (home, irrigation, municipal, industrial)

WELL COMPLETION DATA:

- (1) diameter (inches) 4"
- (2) total depth (feet) 170'
- (3) static water level (feet) 20' below above top of ground.
- (4) casing PVC, 160',
 (material) (depth)
4" If telescope see back.
 (size)
- (5) screen 10', 160'
 (length) (depth to top)
0.10, 160'
 (size) (material)
3/4
 (HP) (yield gpm)
- 220 v
 (type power)
- (7) electric log No
 (yes or no)
 (organization running log)
- (8) how well bottom plugged Cap

description of formations encountered

from to

Red Clay	0	10
Red Sand	10	50
White Sand & clay	50	80
White Sand	80	170


RECEIVED
 JUL 1 - 1985

DRILLERS REMARKS:

Department of Natural Resources
 Bureau of Land & Water Resources

If well telescopes please sketch and show depths.

GROUND LEVEL

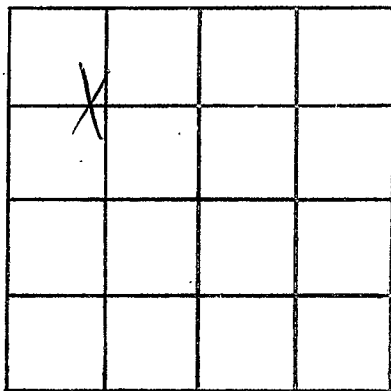

SECTION 16

Please indicate well location X.

ADDITIONAL INFORMATION

If more than one screen,
show locations of each on sketch.