

M. Alstair
R 2040

MISSISSIPPI DEPARTMENT OF NATURAL RESOURCES
Bureau of Land and Water Resources
Southport Mall
P.O. Box 10631
Jackson, Mississippi 39209
WATER WELL DRILLERS LOG

1-9-86 date well completed HICKS WELL COMPANY Marshall county well located
RT. 1 - 507 n p m e


LANDOWNER: Albert's Warden
Rt # 2
Caldwatey ms 38818
(mailing address)

description of formations encountered	from	to
Red clay	0	20
Red sand	20	60
White sand & white clay	60	80
White sand	80	155

WELL LOCATION:
sec. 27 T 5 N R 4 E
S W
1 miles E of Well Hill
(distance) (direction) (nearest town)

WELL PURPOSE: Home
(home, irrigation, municipal, industrial)

- WELL COMPLETION DATA:
- (1) diameter (inches) 4"
 - (2) total depth (feet) 155'
 - (3) static water level (feet) 80' below above top of ground.
 - (4) casing PVC, 145'
(material) (depth)
4"
(size) if telescope see back.
 - (5) screen 10', 145'
(length) (depth to top)
013, PVC
(size) (material)
 - (6) pump 1/2, 10
(HP) (yield gpm)
2700
(type power)
 - (7) electric log no
(yes or no)
(organization running log)
 - (8) how well bottom plugged Cap

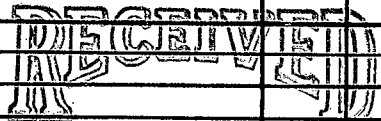


MAY 1 9 1986

DRILLERS REMARKS:

Department of Natural Resources
Bureau of Land & Water Resources

If well telescopes please sketch and show depths.

GROUND LEVEL

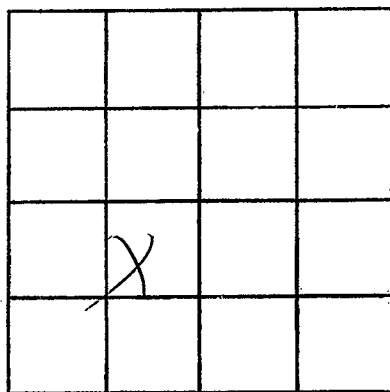

SECTION 27

Please indicate well location X.

ADDITIONAL INFORMATION

If more than one screen,
show locations of each on sketch.