

MISSISSIPPI DEPARTMENT OF NATURAL RESOURCES

Bureau of Land and Water Resources

P.O. Box 10631
Jackson, Mississippi 39209
WATER WELL DRILLERS LOG

COUNTY WELL LOCATED	
<i>Marshall</i>	
WELL NUMBER	CODED
<i>R 2049</i>	
DATE WELL COMPLETED	
<i>6-20-88</i>	

PERMIT NUMBER
NAME OF DRILLING FIRM
<i>FRONS WELL COMPANY</i>
RT. 1 - BOX 157 SEMATOPIA, MISSISSIPPI

NAME & MAILING ADDRESS OF LANDOWNER		
<i>Susie Sengap</i>		
<i>Rt. 3 Chulahoma</i>		
<i>Holly Springs, Ms. 38635</i>		
WELL LOCATION: SEC	TOWNSHIP	RANGE
<i>11</i>	<i>S</i>	<i>4</i>
DISTANCE	DIRECTION	NEAREST TOWN
<i>2</i> Miles	<i>W</i> of	<i>Galena</i>
OTHER LANDMARK		
WELL PURPOSE: <input checked="" type="checkbox"/> Home, <input type="checkbox"/> Irrigation, <input type="checkbox"/> Municipal, <input type="checkbox"/> Industrial, <input type="checkbox"/> Fish Pond, etc.		

PUMP DATA		
PUMP TYPE (Circle One):		
<input checked="" type="checkbox"/> Submersible	<input type="checkbox"/> Turbine	<input type="checkbox"/> Jet
Other (Describe) _____		
POWER TYPE (Circle One):		
<input checked="" type="checkbox"/> Electric	<input type="checkbox"/> Tractor	<input type="checkbox"/> Diesel
<input type="checkbox"/> Gasoline	<input type="checkbox"/> Butane	Other (Describe) _____
Pump Capacity (GPM)	No. of Stages	Setting Depth
<i>10</i>	<i>12</i>	<i>180</i> FT.
PUMP TEST		
Well yielded _____ GPM with		
a drawdown of _____ ft.		
after _____ hours of pumping		

WELL DATA		
Well Depth	Casing Diameter (In.)	Casing Length (Ft.)
<i>220</i>	<i>4</i>	<i>210</i>
Type of Casing	Hole Depth	Depth to Static Water Level
<i>PVC</i>	<i>220</i>	<i>150</i>
TYPE OF COMPLETION: (Circle One or More):		
<input checked="" type="checkbox"/> Gravel Packed	<input type="checkbox"/> Underreamed	<input type="checkbox"/> Telescoped
<input checked="" type="checkbox"/> Natural Development	<input type="checkbox"/> Open Hole	<input type="checkbox"/> Other
(Describe) _____		
Top of Lap Pipe or Reduction in Casing		
FEET <input type="checkbox"/> IF TELESCOPED OR MORE THAN ONE SCREEN: USE BACK PAGE		

LOG DATA	
TYPE OF LOG RUN (Circle One):	
<input type="checkbox"/> Electric	<input checked="" type="checkbox"/> No. Log Run
<input type="checkbox"/> Gamma Ray	<input type="checkbox"/> Density
<input type="checkbox"/> Sonic	<input type="checkbox"/> Neutron
Other (Describe) _____	
Name of Organization Running Log	

SCREEN DATA		
Diameter - Inches	Length - Feet	Slot Size - Inches
<i>4</i>	<i>10</i>	<i>1013</i>
Screen Type	Depth to Bottom - Feet	
<i>PVC</i>	<i>6</i>	

GEOLOGIC DATA (Office Use Only)			
Surface Elev.	Geologic Unit	Unit Thickness	Depth to Top
Subs. SWL	Date	Analysis	Aquifer Test


Driller's Remarks

DESCRIPTION OF FORMATIONS ENCOUNTERED	FROM	TO	FORMATIONS (Continued)	FROM	TO
<i>Red Clay</i>	<i>0</i>	<i>10</i>	<div style="font-size: 2em; font-weight: bold; opacity: 0.5;">RECEIVED</div> <div style="font-size: 1.5em; font-weight: bold; margin-top: 10px;">SEP 19 1988</div> <div style="font-size: 0.8em; margin-top: 10px;"> Department of Natural Resources Bureau of Land & Water Resources </div>		
<i>Red Sand</i>	<i>10</i>	<i>30</i>			
<i>White Sand</i>	<i>30</i>	<i>220</i>			

IF MORE SPACE IS NEEDED, USE BACK

If well telescopes please
sketch and show depths.

GROUND LEVEL

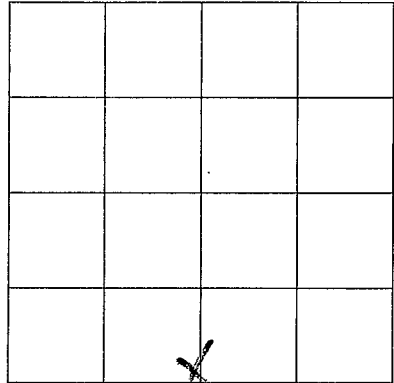

SECTION 11

Please indicate well location X.

ADDITIONAL INFORMATION

If more than one screen,
show location of each on sketch.