

**MISSISSIPPI DEPARTMENT OF ENVIRONMENTAL QUALITY**  
Bureau of Land and Water Resources

P. O. Box 10631  
Jackson, MS 39289-0631  
**WATER WELL DRILLERS LOG**

COUNTY WELL LOCATED <b>Marshall</b>	
WELL NUMBER <b>R 2057</b>	CODED
DATE WELL COMPLETED <b>4-21-93</b>	

PERMIT NUMBER
NAME OF DRILLING FIRM <b>Chicks</b>

NAME & MAILING ADDRESS OF LANDOWNER <b>W. P. HALL Const co</b>			
<b>Rt 1</b>			
<b>Senatobia ms</b>			
WELL LOCATION:	SEC	TOWNSHIP	RANGE
	<b>9</b>	<b>5</b>	<b>4</b>
		<b>N</b>	<b>E</b>
		<b>S</b>	<b>W</b>
DISTANCE	DIRECTION	NEAREST TOWN	
<b>12</b> Miles	<b>West</b>	<b>Holly Springs</b>	
OTHER LANDMARK			
WELL PURPOSE (Home Irrigation, Municipal, Industrial, Fish Pond, etc.)			

PUMP DATA		
PUMP TYPE (Circle One): <b>Submersible</b> Turbine, Jet, Flowing Well, Other (Describe) _____		
POWER TYPE (Circle One): <b>Electric</b> Tractor, Diesel, Gasoline, Butane, Other (Describe) _____ H/P <b>1/2</b>		
Pump Capacity (GPM)	No. of Stages	Setting Depth
<b>10</b>	<b>12</b>	<b>140</b> FT.
PUMP TEST		
Well yielded _____ GPM with a drawdown of _____ ft. after _____ hours of pumping		

WELL DATA		
Well Depth <b>180</b>	Casing Diameter (In.) <b>4"</b>	Casing Length (Ft.) <b>170</b>
Type of Casing <b>PVC</b>	Hole Depth <b>180</b>	Depth to Static Water Level <b>120'</b>
TYPE OF COMPLETION: (Circle One or More): <b>Gravel Packed</b> , Underreamed, Telescoped, Natural Development, Open Hole, Other (Describe) _____		
Top of Lap Pipe or Reduction in Casing		
FEET	IF TELESCOPED OR MORE THAN ONE SCREEN: USE BACK PAGE	

LOG DATA	
TYPE OF LOG RUN (Circle One): <b>Electric</b> , Gamma Ray, Density, Sonic, Neutron, Other (Describe) _____	
Name of Organization Running Log	


SCREEN DATA		
Diameter - Inches <b>4"</b>	Length - Feet <b>10'</b>	Slot Size - Inches <b>.013</b>
Screen Type <b>PVC</b>	Depth to Bottom - Feet <b>10'</b>	

GEOLOGIC DATA (Office Use Only)			
Surface Elev.	Geologic Unit	Unit Thickness	Depth to Top
Subs. SWL	Date	Analysis	Aquifer Test
Driller's Remarks			

DESCRIPTION OF FORMATIONS ENCOUNTERED	FROM	TO	FORMATIONS (Continued)	FROM	TO
<b>Red Sand</b>	<b>0</b>	<b>40</b>	<b>RECEIVED</b>		
<b>CLAY</b>	<b>40</b>	<b>100</b>			
<b>SAND &amp; CLAY</b>	<b>100</b>	<b>120</b>			
<b>White Sand</b>	<b>120</b>	<b>180</b>			
			<b>MAY 25 1993</b>		
			Dept. of Environmental Quality Office of Land & Water Resources		
			IF MORE SPACE IS NEEDED, USE BACK		

If well telescopes please sketch and show depths.

GROUND LEVEL

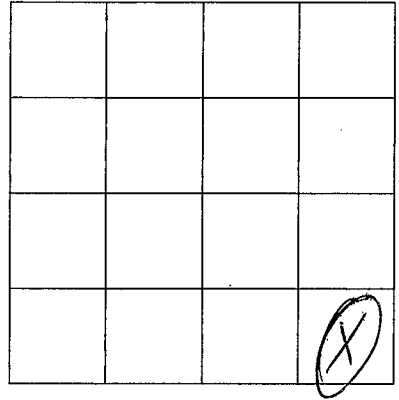

SECTION \_\_\_\_\_

Please indicate well location X.

ADDITIONAL INFORMATION

If more than one screen,  
show location of each on sketch.