

MISSISSIPPI DEPARTMENT OF ENVIRONMENTAL QUALITY

Office of Land and Water Resources

P. O. Box 10631
Jackson, MS 39289-0631
WATER WELL DRILLERS LOG

COUNTY WELL LOCATED
Marshall

WELL NUMBER CODED
R 2062

DATE WELL COMPLETED
10-31-96

PERMIT NUMBER

HICK WATER WELL CO.

30242 HWY. 4 EAST

SENATOBIA, MS 38664

NAME & MAILING ADDRESS OF LANDOWNER
Tom HANECKER
Cedar Oaks Plantation
Mt. Peel Rd
Holly Springs, MS 38635

WELL LOCATION: SEC 13 TOWNSHIP S 4 RANGE W

DISTANCE DIRECTION NEAREST TOWN
1 1/2 Miles W of Adena

OTHER LANDMARK

WELL PURPOSE: Home, Irrigation, Municipal, Industrial, Fish Pond, etc.

PUMP DATA

PUMP TYPE (Circle One):
Submersible Turbine, Jet, Flowing Well,
Other (Describe)

POWER TYPE (Circle One):
Electric Tractor, Diesel, Gasoline, Butane,
Other (Describe) H/P 3

Pump Capacity (GPM) No. of Stages Setting Depth
28 230 FT.

PUMP TEST

Well yielded no GPM with
a drawdown of Test ft.
after _____ hours of pumping

WELL DATA

Well Depth Casing Diameter (In.) Casing Length (Fl.)
234 4" 214

Type of Casing Hole Depth Depth to Static Water Level
PVC 234 180

TYPE OF COMPLETION: (Circle One or More):
Gravel Packed, Underreamed, Telescoped,
Natural Development, Open Hole, Other
(Describe)

WELL GROUTED TO A DEPTH OF 3 FEET
Type Grout (circle one): Cement, Bentonite, or Mix

LOG DATA

TYPE OF LOG-RUN (Circle One): No Log Run,
Electric, Gamma Ray, Density, Sonic, Neutron,
Other (Describe)

Name of Organization Running Log

SCREEN DATA

Diameter - Inches Length - Feet Slot Size - Inches
4 20 .013

Screen Type Depth to Bottom - Feet
PVC slot 214

GEOLOGIC DATA (Office Use Only)

Surface Elev.	Geologic Unit	Unit Thickness	Depth to Top
Subs. SWL	Date	Analysis	Aquifer Test

DESCRIPTION OF FORMATIONS ENCOUNTERED	FROM	TO
<u>Red Clay</u>	<u>0</u>	<u>10</u>
<u>Red Sand</u>	<u>10</u>	<u>50</u>
<u>White Sand + Clay</u>	<u>50</u>	<u>150</u>
<u>White Sand</u>	<u>150</u>	<u>234</u>

Driller's Remarks

Top of Lap Pipe or Reduction in Casing

IF TELESCOPED OR MORE THAN ONE SCREEN USE BACK PAGE

RECEIVED


APR 11 1997

Dept. of Environmental Quality
Office of Land & Water Resources

IF MORE SPACE IS NEEDED, USE BACK

If well telescopes please
sketch and show depths.

GROUND LEVEL

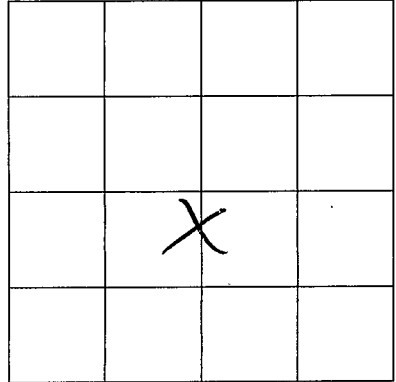

SECTION 13

Please indicate well location X.

ADDITIONAL INFORMATION

If more than one screen,
show location of each on sketch.